

STATE OF KANSAS
STATE CORPORATION COMMISSION


WELL PLUGGING RECORD

Give All Information Completely
Make Required A
Mail or Deliver
Conservation
State Corporation Commission
800 Bittling Building
Wichita, Kansas

OR
FORMATION PLUGGING RECORD

Strike out upper line
when reporting plug-
ging off formations.

NORTH

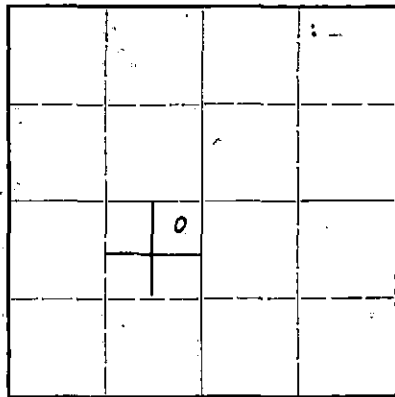

Locate well correctly on above
Section Plat

Barston County. Sec. 12 Twp. 21S Rge. 21E (E) 21 (W)
Location as "NE1/4NW1/4SW1/4" or footage from lines. 113 113 07
Lease Owner. W. L. Hartman
Lease Name. Miss
Office Address. W. L. Hartman, Box 54, Wichita, Kansas
Character of Well (completed as Oil, Gas or Dry Hole). Dry Hole
Date well completed. 19
Application for plugging filed. January 31, 1946 19
Application for plugging approved. January 31, 1946 19
Plugging commenced. February 1, 1946 19
Plugging completed. February 7, 1946 19
Reason for abandonment of well or producing formation. Dry Hole

If a producing well is abandoned, date of last production. 19
Was permission obtained from the Conservation Division or its agents before plugging was com-
menced? Yes

Name of Conservation Agent who supervised plugging of this well. H. W. Korr
Producing formation. Depth to top. Bottom. Total Depth of Well. 3701 Feet
Show depth and thickness of all water, oil and gas formations.

OIL, GAS OR WATER RECORDS


CASING RECORD

Formation	Content	From	To	Size	Put In	Pulled Out
Surface	385'	0	305	8 5/8	305	None
Oil string	367 1/2'	0	367 1/2'	5 1/2	367 1/2'	1728'

Describe in detail the manner in which the well was plugged, indicating where the mud fluid was placed and the method or methods used in introducing it into the hold. If cement or other plugs were used, state the character of same and depth placed, from feet to feet for each plug set.

Dumped 5 sacks cement at 3699', filled to 3663', mudded hole with heavy mud from 3663' to 270, set 12" rock bridge, dumped 15 sacks cement. Filled hole with heavy mud to 12", dumped 10 sacks cement, cement returned to base of cellar.

PLUGGING
FILE 12 21 14W
BOOK 43 16

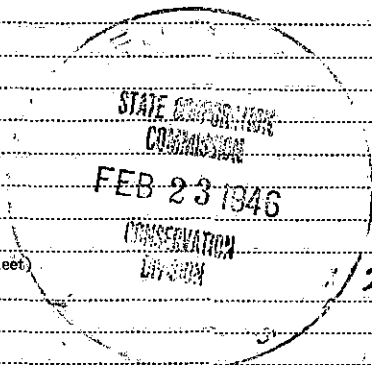

(If additional description is necessary, use BACK of this sheet)
Correspondence regarding this well should be addressed to W. L. Hartman
Address Box 54, Wichita, Kansas

STATE OF KANSAS COUNTY OF BARSTON
I, J. T. Phoenix, (employee of owner) or (owner or operator) of the above-described well,
being first duly sworn on oath, says: That I have knowledge of the facts, statements, and matters herein contained and the log of the above-
described well as filed and that the same are true and correct. So help me God.

(Signature) J. T. Phoenix
Ellinwood, Kansas

(Address) 16

SUBSCRIBED AND SWORN to before me this 13th day of February, 1946

J. J. Rader

Notary Public

My commission expires:

July 7, 1948

WELL LOG

W. L. Hartman, et al, Owner - Hiss #1

NE NE SW Section 12, Township 21 S, Range 14 W
Barton County, Kansas

Figures indicate bottom of formation

	0	to	240	Sand
			255	Shale and shells
Elevation	1922		345	Sand
			385	Shale and red bed
Pipe:			816	Red bed
			842	Anhydrite
8 5/8" set at	385		1095	Red bed and shale
5 1/2" 14# set at	3675 1/2		1285	Shale and salt
			1378	Shale
			1575	Salt, shale and shells
Tops			1700	Shale and lime shells
			1785	Shale and shells
Anhydrite	816		2100	Broken lime
Topeka	2086		2475	Lime
Hobner Shale	3229		2590	Shale
K.C. Brown	3346		2785	Shale and shells
K.C. White	3366		2914	Shale
Base K.C.	3588		3014	Shale and lime
Simpson	3628		3075	Shale and broken lime
Arbuckle	3675		3175	Broken lime
			3677	Lime
Commenced Rotary December 1, 1945			3677	Total Rotary Depth
Rotary completed December 13, 1945			3704	Total Cable Tool Depth

Cable Tool commenced December 19, 1945
Cable Tool completed December 23, 1945

State of Kansas)
County of Barton) ss

I, J. T. Phoenix, Employee of Owner of the above-described well, being first duly sworn on oath, declare: That I have knowledge of the facts, statements and matters herein contained pertaining to the log of the above-described well as filed and that the same are true and correct.

J. T. Phoenix

Subscribed and Sworn to before me this 13th day of February 1946.

J. J. Rader

My commission expires July 7, 1948.

12 21 14W
43 16