

STATE OF KANSAS
STATE CORPORATION COMMISSION

WELL PLUGGING RECORD

Give All Information Completely
Make Required Affidavit
Mail or Deliver Report to:
Conservation Division
State Corporation Commission
212 No. Market
Wichita, Kansas

Pawnee County, Sec. 3 Twp. 23 Rge. 17 (E) (W)

Location as "NE/CNW/SW" or footage from lines SE SE SE

Lease Owner Colorado Oil Company

Lease Name Hutchinson Well No. 8

Office Address 915 Union National Building Wichita, Kansas

Character of Well (completed as Oil, Gas or Dry Hole) _____

Date well completed _____ 19____

Application for plugging filed _____ 19____

Application for plugging approved _____ 19____

Plugging commenced 4-10-69 _____ 19____

Plugging completed 4-19-69 _____ 19____

Reason for abandonment of well or producing formation _____

If a producing well is abandoned, date of last production _____ 19____

Was permission obtained from the Conservation Division or its agents before plugging was commenced? Yes

Name of Conservation Agent who supervised plugging of this well Leo F. Massey

Producing formation _____ Depth to top _____ Bottom _____ Total Depth of Well 4315 Feet

Show depth and thickness of all water, oil and gas formations.

OIL, GAS OR WATER RECORDS

CASING RECORD

FORMATION	CONTENT	FROM	TO	SIZE	PUT IN	PULLED OUT
				8 5/8	234	None
				5 1/2	None	2713

Describe in detail the manner in which the well was plugged, indicating where the mud fluid was placed and the method or methods used in introducing it into the hole. If cement or other plugs were used, state the character of same and depth placed, from _____ feet to _____ feet for each plug set.

Moved in. Rigged up. Put on head.

Rigged up jacks. Rigged up pump truck to pump cement.

Pumped 10 sacks of cement.

Shot casing at 13120' - 2916' 2830' and 2719'. Working pipe.

Pulling pipe.

Squeezed well with 5 sacks of hulls, 20 sacks of mud and 100 sacks of cement.

(If additional description is necessary, use BACK of this sheet)

Name of Plugging Contractor Forbes Casing Pulling, Inc.

Address P. O. Box 221 Great Bend, Kansas

STATE OF Kansas, COUNTY OF Barton, ss.
J. O. Forbes (employee of owner) or (owner or operator) of the above-described well, being first duly sworn on oath, says: That I have knowledge of the facts, statements, and matters herein contained and the log of the above-described well as filed and that the same are true and correct. So help me God.

(Signature) J. O. Forbes

P. O. Box 221 Great Bend, Kansas
(Address)

SUBSCRIBED AND SWORN TO before me this 25 day of April, 1969

My commission expires May 27, 1969

Glenn Clark
Notary Public.

RECEIVED
STATE CORPORATION COMMISSION
APR 29 1969
CONSERVATION DIVISION
Wichita, Kansas

DRILLERS LOG

15-145-01131-000D

Hutchinson "H" No. 8
 Loc: SE SE SE
 Sec: 3-23-17
 Pawnee County, Kansas
 Company: Colorado Oil & Gas Corporation
 Contractor: Honaker Drilg., Inc.

Comm: 1-25-56
 Comp: 2- 5-56
 Rotary Total Depth: 4315
 Casing: 8 5/8 at 234'
 5 1/2 at 4314

0	60	Sand	
60	180	Clay & Shale	
180	375	Blue Shale	8 5/8" casing cemented at
375	560	Red Bed & Shale	234' with 175 sacks cement
560	670	Sandy Red Bed	& 2% calcium chloride
670	760	Dakota Sand	
760	1115	Shale & Shells	
1115	1135	Anhydrite	
1135	1920	Shale & Shells	
1920	1930	Shale & Lime	
1930	4174	Lime & Shale	
4174	4255	Lime & Chert	
4255	4281	Chert & Lime	5 1/2" casing set at 4314'
4281	4315	Lime & Chert	with 175 sacks cement
4315		Total Rotary Depth	

RECEIVED
 STATE CORPORATION COMMISSION
 JAN 29 1969
 CONSERVATION DIVISION
 Wichita, Kansas

I certify that this is the true and correct copy
 of the above log to the best of my knowledge.

H.S. Forbes
 H.S. Forbes

Subscribed and sworn to before me this 14th day
 of February, 1956.


Kenneth G. Fischer
 Kenneth G. Fischer, Notary Public

My commission expires: 6-25-59

Give All Information Completely
Make Required Affidavit
Mail or Deliver Report to:
Conservation Division
State Corporation Commission
211 No. Broadway
Wichita, Kansas

WELL PLUGGING RECORD

NORTH

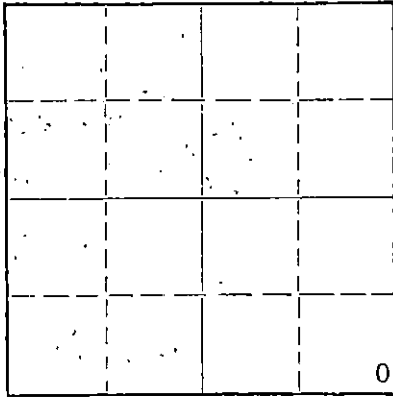

Locate well correctly on above Section Plat

Pawnee County, Sec. 3 Twp. 23 Rge. (E) 17 (W)
Location as "NE/CNW/SW" or footage from lines SE SE SE
Lease Owner Colorado Oil Company
Lease Name Hutchinson "H" Well No. 8
Office Address 915 Union Natl. Bldg., Wichita, Kansas
Character of Well (completed as Oil, Gas or Dry Hole) Conv. to Inj. January, 1958
Date well completed February 17 19 56
Application for plugging filed January 28 19 69
Application for plugging approved January 29 19 69
Plugging commenced April 10 19 69
Plugging completed April 19 19 69
Reason for abandonment of well or producing formation Depleted

If a producing well is abandoned, date of last production 19
Was permission obtained from the Conservation Division or its agents before plugging was commenced? Yes

Name of Conservation Agent who supervised plugging of this well Leo Massey
Producing formation Congl. Chert Depth to top 4182 Bottom Total Depth of Well 4315 Feet
Show depth and thickness of all water, oil and gas formations.

OIL, GAS OR WATER RECORDS

CASING RECORD

FORMATION	CONTENT	FROM	TO	SIZE	PUT IN	PULLED OUT
				8-5/8"	234	None
				5-1/2"	4314	2713

Describe in detail the manner in which the well was plugged, indicating where the mud fluid was placed and the method or methods used in introducing it into the hole. If cement or other plugs were used, state the character of same and depth placed, from feet to feet for each plug set.

Moved in, rigged up, put on head. Rigged up jacks, rigged up to pump cement. Pumped 10 sacks of cement. Shot casing at 3120', 2916', 2830' & 2719'. Pulled pipe. Squeezed with 5 sacks hulls, 20 sacks mud and 100 sacks of cement.

RECEIVED
STATE CORPORATION COMMISSION
MAY 7 1969
CONSERVATION DIVISION
Wichita, Kansas

(If additional description is necessary, use BACK of this sheet)

Name of Plugging Contractor Forbes Casing Pulling, Inc.
Address P. O. Box 221, Great Bend, Kansas

STATE OF Kansas, COUNTY OF Sedgwick, ss.

Bill K. Henrichs (employee of owner) or (owner or operator) of the above-described well, being first duly sworn on oath, says: That I have knowledge of the facts, statements, and matters herein contained and the log of the above-described well as filed and that the same are true and correct. So help me God.

(Signature) Bill K. Henrichs
915 Union Natl. Bldg., Wichita, Kansas
(Address)

Subscribed and sworn to before me this 6th day of May, 19 69

Betty J. McElwain
Betty J. McElwain Notary Public.

My commission expires February 19, 1973

