

STATE OF KANSAS  
STATE CORPORATION COMMISSION

WELL PLUGGING RECORD

Give All Information Completely  
Make Required Affidavit  
Mail or Deliver Report to:  
Conservation Division  
State Corporation Commission  
211 N. Broadway  
Wichita, Kansas

STAFFORD County, Sec. 8 Twp. 21 Rge. 13 (E) (W)

Location as "NE/CNW/SW" or footage from lines NW NW SE

Lease Owner PETROLEUM, INC.,

Lease Name DELL EAST 1-KC UNIT Well No. 2-1

Office Address R. R. #2, GREAT BEND, KANSAS

Character of Well (completed as Oil, Gas or Dry Hole) OIL

Date well completed 8-29 1956

Application for plugging filed 10-22 1963

Application for plugging approved 10-24 1963

Plugging commenced 10-25 1963


Plugging completed 10-28 1963

Reason for abandonment of well or producing formation DEPLETION OF PRODUCIBLE ZONES

If a producing well is abandoned, date of last production APRIL 30 1963

Was permission obtained from the Conservation Division or its agents before plugging was commenced? YES

NORTH

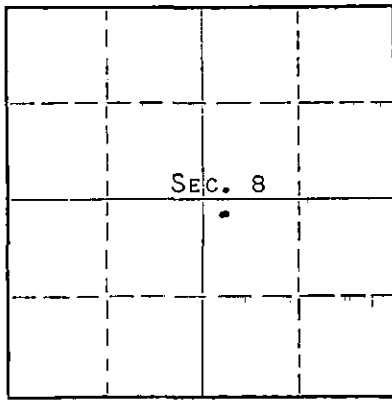

Locate well correctly on above Section Plat

Name of Conservation Agent who supervised plugging of this well ARCHIE ELVING

Producing formation KANSAS CITY Depth to top 3312 Bottom 3536 Total Depth of Well 3589 Feet

Show depth and thickness of all water, oil and gas formations.

OIL, GAS OR WATER RECORDS

CASING RECORD

FORMATION	CONTENT	FROM	TO	SIZE	PUT IN	PULLED OUT
KANSAS CITY	WATER, LITTLE	3453	3458	8-5/8	214	NONE
	OIL			5-1/2	14#	2878

Describe in detail the manner in which the well was plugged, indicating where the mud fluid was placed and the method or methods used in introducing it into the hole. If cement or other plugs were used, state the character of same and depth placed, from feet to feet for each plug set.

PLUGGED BACK 3472, FILLED HOLE WITH CRUSHED ROCK FROM 3472 TO 3440, PLACED 5 SACKS CEMENT ON TOP OF CRUSHED ROCK. MUDDED UP WITH HEAVY MUD TO 250'. PUSHED WOODEN PLUG TO 250', MADE A ROCK BRIDGE, WENT IN, CHECKED BRIDGE, FOUND BRIDGE GONE. SQUEEZED THE HOLE WITH 15 SACKS GEL AND 75 SACKS CEMENT. CHECKED & FOUND CEMENT @ 15', FILLED WITH 5 SACKS CEMENT TO BASE OF WELL CELLAR.

RECEIVED  
STATE CORPORATION COMMISSION

NOV 12 1963

CONSERVATION DIVISION  
Wichita, Kansas

11-12-63

(If additional description is necessary, use BACK of this sheet)

Name of Plugging Contractor SOUTHWEST CASING AND PULLING CO., INC.

Address Box 364, GREAT BEND, KANSAS

STATE OF KANSAS, COUNTY OF BARTON, ss. MONTE CHADD (employee of owner) or (owner or operator) of the above-described well, being first duly sworn on oath, says: That I have knowledge of the facts, statements, and matters herein contained and the log of the above-described well as filed and that the same are true and correct. So help me God. MONTE CHADD, DIST. PRD. SUPT.

(Signature) Monte Chadd

R. R. #2, GREAT BEND, KANSAS

(Address)

SUBSCRIBED AND SWORN to before me this 6TH day of NOVEMBER 1963

My commission expires SEPTEMBER 23, 1967

Notary Public.

Petroleum, Inc., Lease Owner

Section 8, Two. 21S, Rge. 13W

Garvey Drilling Company, Contractor

Location: NW NW SE

Drilling Commenced: July 19, 1952

County: Stafford

Drilling Completed: July 29, 1952

R.T.D.: 3589'

Casing Record: 8 5/8" @ 214' w/175 sax  
 5 1/4" @ 3585' w/75 sax

figures below indicate bottom of formations:

		Tops:
100	Sand & Shale:	Heebner: 3182 (-1276)
115	Hard Sand	Brown Lime: 3304 (-1398)
420	Shale & Shells	Lansing: 3316 (-1410)
630	Red Bed	Arbucklet: 3582 (-1676)
775	Red Bed & Shells	
800	Anhydrite	
1800	Shale & Shells	DST #1, 3328-65, open 25 mins., rec. 15' mud, Off BHP.
2050	Lime	DST #2, 3429-44, open 40 mins., rec. 10' very slightly oil cut mud, Off BHP
2290	Shale & Lime	DST #3, 3448-63, open 1 hour, rec. 20' heavily oil cut mud plus 450' froggy oil, 850# BHP.
2530	Shale & Shells	DST #4, 3468-80, open 1 hour, rec. 20' mud, Off BHP.
3080	Lime & Shale	DST #5, 3483-3526, open 1 hour, rec. 75' oil cut mud, 600# BHP.
3589	Lime	DST #6, 3584-89, open 1 hour, rec. 100' oil plus 300' gas plus 50' oil cut mud, 400# BHP.
3589'	R.T.D.	

I hereby certify that this is a true and correct log of the above mentioned well.

PETROLEUM, INC.

RECEIVED  
 STATE CORPORATION COMMISSION

*W.W. Fisher*

NOV 12 1963

STATE OF KANSAS )  
 )  
 COUNTY OF SEDGWICK )

SS: CONSERVATION DIVISION  
 Wichita, Kansas

Subscribed to and sworn to before me, a Notary Public in said County and State, this 2nd day of August, 1952.

*Shelton Hader*  
 Notary Public

My commission expires: October 13, 1954