


STATE OF KANSAS
STATE CORPORATION COMMISSION

WELL PLUGGING RECORD

Give All Information Completely
Make Required Affidavit
Mail or Deliver Report to:
Conservation Division
State Corporation Commission
211 No. Broadway
Wichita, Kansas

STAFFORD County. Sec. 8 Twp. 21s Rge. 13W (X) (W)

NORTH

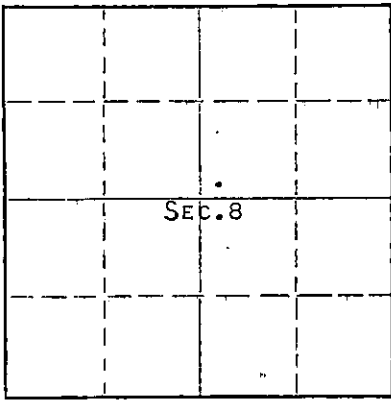

Locate well correctly on above
Section Plat

Location as "NE/CNW/SW" or footage from lines SW SW NE
Lease Owner PETROLEUM, INC.,
Lease Name DELL EAST 1-KC Well No. 1-1
Office Address R. R. #2, GREAT BEND, KANSAS
Character of Well (completed as Oil, Gas or Dry Hole) OIL
Date well completed FEB. 14, 19 52
Application for plugging filed OCT. 22, 19 63
Application for plugging approved OCT. 25, 19 63
Plugging commenced OCT. 30, 19 63
Plugging completed NOV. 5, 19 63
Reason for abandonment of well or producing formation DEPLETION OF PRODUCIBLE ZONES

If a producing well is abandoned, date of last production APRIL 30, 19 63
Was permission obtained from the Conservation Division or its agents before plugging was commenced? YES

Name of Conservation Agent who supervised plugging of this well ARCHIE ELVING
Producing formation KANSAS CITY Depth to top 3317 Bottom 3536 Total Depth of Well 3650 Feet
Show depth and thickness of all water, oil and gas formations.

OIL, GAS OR WATER RECORDS

CASING RECORD

FORMATION	CONTENT	FROM	TO	SIZE	PUT IN	PULLED OUT
KANSAS CITY	WATER &					
	LITTLE OIL	3452	3460	8-5/8"	203	NONE
				5-1/2"	3649	3143'

Describe in detail the manner in which the well was plugged, indicating where the mud fluid was placed and the method or methods used in introducing it into the hole. If cement or other plugs were used, state the character of same and depth placed, from _____ feet to _____ feet for each plug set.

PLUG BACK TO 3502

FILLED HOLE WITH CRUSHED ROCK FROM 3502 TO 3440', PLACED 5 SACKS OF CEMENT ON TOP OF CRUSHED ROCK. MUDDING UP WITH 15 SACKS OF HEAVY MUD, FILLED HOLE WITH 75 SACKS CEMENT TO BASE OF WELL CELLAR.

RECEIVED
STATE CORPORATION COMMISSION

NOV 14 1963

CONSERVATION DIVISION
Wichita, Kansas

11-14-63

(If additional description is necessary, use BACK of this sheet)

Name of Plugging Contractor SOUTHWEST CASING PULLING Co., INC.
Address BOX 364, GREAT BEND, KANSAS

STATE OF KANSAS COUNTY OF BARTON, ss.
MONTE CHADD (employee of owner) or (~~owner or operator~~) of the above-described well, being first duly sworn on oath, says: That I have knowledge of the facts, statements, and matters herein contained and the log of the above-described well as filed and that the same are true and correct. So help me God. MONTE CHADD, DIST. PROD. SUPT.

(Signature) Monte Chadd
R. R. #2, GREAT BEND, KANSAS
(Address)

SUBSCRIBED AND SWORN TO before me this 11TH day of NOVEMBER 19 63

My commission expires SEPTEMBER 23, 1967

Howard E. Packer
Notary Public.

WELL LOG FISCHER NO. 1

Petroleum, Inc. & Omega Oil, Lease Owners

Section 8, Twp. 21S, Rge. 13W

Garvey Drilling Company, Contractor

Location: SW SW NE

Drilling Commenced: January 13, 1952

County: Stafford, Kansas

Drilling Completed: January 25, 1952

Production: Lansing-Kansas City

Casing Record: 8 5/8" @ 203' w/175 sax
5 1/2" @ 3649' w/75 sax

R.T.D. 3650'

Figures below indicate bottom of formation:

- 10 Surface Clay
- 110 Shale & Sand
- 135 Hard Sand Rock
- 190 Sand
- 203 Shale & Shells
- 225 Blue Shale
- 310 Sand
- 610 Shale, Shells & Red Bed
- 777 Red Bed
- 900 Anhydrite
- 1665 Shale & Shells
- 2200 Lime & Shale
- 2660 Shale & Shells
- 2820 Shale, Lime & Shells
- 2920 Lime & Shale
- 3182 Lime
- 3265 Shale & Lime
- 3317 Shale
- 3356 Lime
- 3399 Lime & Shale
- 3544 Lime
- 3554 Conglomerate
- 3564 Shale
- 3570 Shale & Conglomerate
- 3576 Arbuckle
- 3650 Lime
- 3650' R.T.D.

Tops:

- Heebner: 3182 (-1276)
- Brown Lime: 3304 (-1398)
- Lansing: 3317 (-1411)
- Arbuckle: 3570 (-1664)

RECEIVED
STATE CORPORATION COMMISSION
NOV 14 1963
CONSERVATION DIVISION
Wichita, Kansas

I hereby certify that this is a true and correct log of the above mentioned well.

PETROLEUM, INC.

By Charles H. Wilson

STATE OF KANSAS)
) SS:
COUNTY OF SEDGWICK)

Subscribed to and sworn to before me, a Notary Public in said County and State, this 1st day of February, 1952.
My commission expires: October 27, 1952.

Margaret Bradshaw