

15.185.19118.0000


STATE OF KANSAS
STATE CORPORATION COMMISSION

WELL PLUGGING RECORD

Give All Information Completely
Make Required Affidavit
Mail or Deliver Report to:
Conservation Division
State Corporation Commission
800 Bitling Building
Wichita, Kansas

Stafford County. Sec. 8 Twp. 21 Rge. (E) 13 (W)
Location as "NE/CNW $\frac{1}{4}$ /SW $\frac{1}{4}$ " or footage from lines NW. NW. NW.
Lease Owner Westgate-Greenland Oil Company
Lease Name Reed Well No. 1
Office Address 1009 Central Building, Wichita 2, Kansas
Character of Well (completed as Oil, Gas or Dry Hole) lost hole
Date well completed June 3, 1951 19
Application for plugging filed June 3, 1951 19
Application for plugging approved June 3, 1951 19
Plugging commenced June 3, 1951 19
Plugging completed June 3, 1951 19
Reason for abandonment of well or producing formation lost tester and had to
abandon hole
If a producing well is abandoned, date of last production 19
Was permission obtained from the Conservation Division or its agents before plugging was com-
menced? yes

NORTH

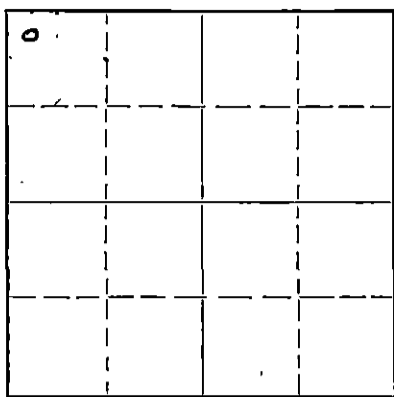

Locate well correctly on above
Section Plat

Name of Conservation Agent who supervised plugging of this well
Producing formation Depth to top Bottom Total Depth of Well 3447 Feet
Show depth and thickness of all water, oil and gas formations.

OIL, GAS OR WATER RECORDS

CASING RECORD

Formation	Content	From	To	Size	Put In	Pulled Out
Surface		0	217	8 5/8"	217	none

Describe in detail the manner in which the well was plugged, indicating where the mud fluid was placed and the method or methods used in introducing it into the hole. If cement or other plugs were used, state the character of same and depth placed, from feet to feet for each plug set.
Filled hole with heavy mud from 3447 feet to 160 feet
Set Halliburton plug and ran 15 sacks cement to 120 feet
Filled with heavy mud from 120 feet to 40 feet
Set Halliburton plug at 40 feet and ran 10 sacks cement to cellar

(If additional description is necessary, use BACK of this sheet)

Correspondence regarding this well should be addressed to Westgate-Greenland Oil Company
Address 1009 Central Building Wichita, Kansas

STATE OF Kansas, COUNTY OF Sedgwick, ss.
G. E. Bitler (employee of owner) or (owner or operator) of the above-described well,
being first duly sworn on oath, says: That I have knowledge of the facts, statements, and matters herein contained and the log of the above-described well as filed and that the same are true and correct. So help me God.

(Signature) G. E. Bitler
1009 Central Building, Wichita 2, Kansas
(Address)

SUBSCRIBED AND SWORN TO before me this 5th day of June, 19 51

My commission expires May 25, 1953.

Esther L. Russell
RECEIVED
STATE CORPORATION COMMISSION

Notary Public.

23-5091-s 8-50-10M

PLUGGING
FILE SEC 8 T 21 R 13W
BOOK PAGE 86 LINE 3

JUN - 7 1951
CONSERVATION DIVISION
Wichita

DRILLERS LOG

COMPANY: Westgate-Greenland Oil Company
 CONTRACTOR: Jackson Drilling Corporation
 FARM: Reed No. 1
 LOCATION: NW NW NW Sec. 8-21-13W, Stafford County, Kansas
 ELEVATION: 1907 DF
 COMMENCED: May 23, 1951
 COMPLETED: June 3, 1951

0	to	100	sand
100	to	155	Shale and sand
155	to	380	Shale
380	to	570	Sand
570	to	800	Shale and red bed
800	to	840	Anhydrite
840	to	1170	Shale and red bed
1170	to	1375	Shale and shells
1375	to	1610	Shale
1610	to	1725	Shale-Brown Lime
1725	to	1735	Lime
1735	to	1995	Lime and Shale
1995	to	2005	Shale and broken lime
2005	to	2595	Lime and shale
2595	to	2690	Shale and broken lime
2690	to	3025	Shale and lime
3025	to	3055	Lime
3055	to	3305	Lime and shale
3305	to	3315	Lime
3315	to	3371	Lime and shale
3371	to	3447	Lime

Set 217 feet 8 5/8" Surface Pipe. Cemented with 160 sacks cement and 2 sacks Calcium chloride

Tops: Anhydrite-800; Heebner-3184; Brown Lime-3303; Lansing-3313.

Tester caught in hole at 3447, hole lost and abandoned.

C E R T I F I C A T E

I, Harold A. Burt, do hereby certify that the above and foregoing is a true and correct copy of log of the Reed #1, Section 8-21-13W, Stafford County, Kansas, as reflected by filed of the Jackson Drilling Corporation.

Harold A. Burt
Harold A. Burt

Subscribed and sworn to before me, a Notary Public, within and for Sedgwick County, Kansas, this 6th day of June, 1951.

Esther Russell
Notary Public

My commission expires May 25, 1953.

PLUGGING
FILE SEC-8-21-13W
BOOK PAGE-86 LINE-3

RECEIVED
STATE CORPORATION COMMISSION
JUN - 7 1951
CONSERVATION DIVISION
Wichita, Kansas