

WELL PLUGGING RECORD

STATE OF KANSAS STATE CORPORATION COMMISSION

Give All Information Completely Make Required Affidavit Mail or Deliver Report to: Conservation Division State Corporation Commission 800 Bittling Building Wichita, Kansas

OR

FORMATION PLUGGING RECORD

Strike out upper line when reporting plugging off formations.

Stafford County, Sec. 8 Twp. 21 Rge. EX 13(W)

Location as "NE 1/4 NW 1/4 SW 1/4" or footage from lines SE SW SE

Lease Owner George Johnston

Lease Name C. H. Harter Well No. 1

Office Address Orpheum Building - Wichita, Kansas

Character of Well (completed as Oil, Gas or Dry Hole) Lost hole

Date well completed 10/28 1948

Application for plugging filed 10/28 1948

Application for plugging approved 10/28 1948


Plugging commenced 10/28 1948

Plugging completed 10/28 1948

Reason for abandonment of well or producing formation Lost hole

If a producing well is abandoned, date of last production 19

Was permission obtained from the Conservation Division or its agents before plugging was commenced? Yes

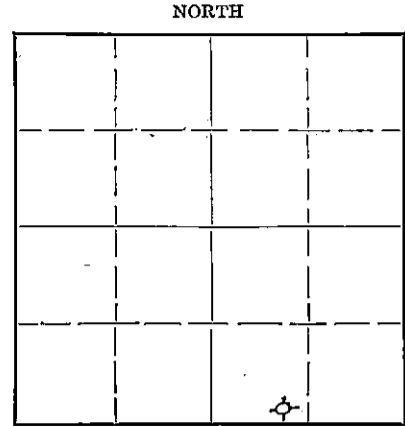

Locate well correctly on above Section Plat

Name of Conservation Agent who supervised plugging of this well C. D. Stough

Producing formation Depth to top Bottom Total Depth of Well 1075 Feet

Show depth and thickness of all water, oil and gas formations.

OIL, GAS OR WATER RECORDS

CASING RECORD

Table with 7 columns: Formation, Content, From, To, Size, Put In, Pulled Out. The table is currently empty.

Describe in detail the manner in which the well was plugged, indicating where the mud fluid was placed and the method or methods used in introducing it into the hole. If cement or other plugs were used, state the character of same and depth placed, from feet to feet for each plug set.

Pushed 2 Halliburton plugs to base of surface (283')

Cemented with 120 sax bulk cement thru drill pipe.

Cement filled up 60' from surface. 3rd Halliburton

plug set 15' from surface and 10 sax cement

(Halliburton process)

11-12-48

RECEIVED

NOV 12 1948

STATE CORPORATION COMMISSION KANSAS

(If additional description is necessary, use BACK of this sheet)

Correspondence regarding this well should be addressed to Brunson Drilling Co., Inc. Address 302 Central Building Wichita, Kansas

STATE OF Kansas COUNTY OF Sedgwick ss. Howard D. Brunson (employee of owner) or owner representative of the above-described well,

being first duly sworn on oath, says: That I have knowledge of the facts, statements, and matters herein contained and the log of the above-described well as filed and that the same are true and correct. So help me God. Brunson Drilling Co., Inc.

(Signature) BY [Signature]


302 Central Bldg. - Wichita, Kansas (Address)

SUBSCRIBED AND SWORN to before me this 10th day of November, 1948

[Signature]

Notary Public.

My commission expires September 10, 1951

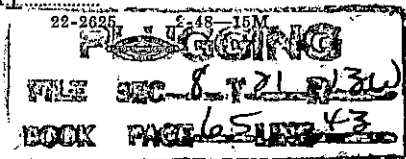

GEORGE F. JOHNSTON

304 Orpheum Bldg.

Wichita, Kansas

C. H. Harter # 1

Sec. 8-21S-13W
Stafford, Kansas

Commenced RD : 10/24/48
Completed RD : 10/28/48
Total Depth : 1075'

Elevation :
Contractor : Brunson Drilling Co., Inc.
Tools : Rotary

Casing - 283' - 8 5/8" surface

STRATA	DEPTH
Sand	71
Pyrite	120
Pyrite of Iron (hard)	135
Shale & shells	155
Sand & shells	180
Sand, shale & shells	200
Sand & shells	250
Sand & shale	265
Shale & shells	420
Redbed & shells	795
Anhydrate	825
Shale & shells	880
Redbed & shale	950
Redbed & shells	1000
Shale & shells	1073
Junk	1075
Total Depth	1075

RECEIVED

Comm. Div.

NOV 12 1948

STATE CORPORATION
COMMISSION
KANSAS

PLUGGING
FILE NO. 8-21-13W
BOOK PAGE 65 LINE 43