


STATE OF KANSAS  
STATE CORPORATION COMMISSION

Give All Information Completely  
Make Required Affidavit  
Mail or Deliver Report to:  
Conservation Division  
State Corporation Commission  
800 Bittling Building  
Wichita, Kansas

WELL PLUGGING RECORD

Stafford County, Sec. 8 Twp. 21 Rge. 13 (X) W (W)

Location as "NE/CNW/SW" or footage from lines NE NE SW  
Lease Owner The El Dorado Refining Company  
Lease Name DIAMOND Well No. 1  
Office Address Box 551 - El Dorado, Kansas  
Character of Well (completed as Oil, Gas or Dry Hole) Dry Hole  
Date well completed 3-31 19 52  
Application for plugging filed 4-7 19 52  
Application for plugging approved 4-9 19 52  
Plugging commenced 4-14 19 52  
Plugging completed 4-24 19 52  
Reason for abandonment of well or producing formation Dry Hole.

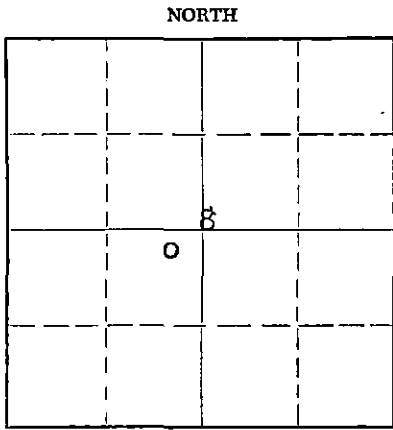

Locate well correctly on above  
Section Plat

If a producing well is abandoned, date of last production 19  
Was permission obtained from the Conservation Division or its agents before plugging was commenced? Yes.

Name of Conservation Agent who supervised plugging of this well Mr. M. A. Rives  
Producing formation Arb. Depth to top 3600 Bottom 3626 Total Depth of Well 3626 Feet  
Show depth and thickness of all water, oil and gas formations.

OIL, GAS OR WATER RECORDS

CASING RECORD

FORMATION	CONTENT	FROM	TO	SIZE	PUT IN	PULLED OUT
				8-5/8	245'	000'
				5-1/2	3599'	2955'

Describe in detail the manner in which the well was plugged, indicating where the mud fluid was placed and the method or methods used in introducing it into the hole. If cement or other plugs were used, state the character of same and depth placed, from \_\_\_\_\_ feet to \_\_\_\_\_ feet for each plug set.

Filled hole with sand to 3480'  
Ran five sacks of cement at 3445'  
Mudded to 240' - Set bridge 230'  
Ran 15 sacks at 185' mudded to 35'  
and set rock bridge at 30' to bottom  
of cellar & cemented with 10 sacks.

RECEIVED  
STATE CORPORATION COMMISSION  
MAY - 7 1952  
CONSERVATION DIVISION  
Wichita, Kansas

5-7-52

(If additional description is necessary, use BACK of this sheet)

Name of Plugging Contractor Pipe Pulling Inc.  
Address Stafford, Kansas

STATE OF KANSAS, COUNTY OF RUSSELL, ss.  
Levi B. Sherman (employee of owner) or (owner or operator) of the above-described well, being first duly sworn on oath, says: That I have knowledge of the facts, statements, and matters herein contained and the log of the above-described well as filed and that the same are true and correct. So help me God.

(Signature) Levi B. Sherman  
Box 209 - Russell, Kansas  
(Address)

SUBSCRIBED AND SWORN TO before me this 6 day of May, 19 52

Herbert B. Fard  
Notary Public.

My commission expires 8-13-55

PLUGGING  
FILED 8-11-1952  
BOOK PAGE 7-1952-19

15.185.11521.0000

# THE EL DORADO REFINING COMPANY

EL DORADO, KANSAS

DRILLER'S LOG NO. 1 DIAMOND

El Dorado Refining Company, lease owner Section 8, Twp. 21S, Rge. 13W.

Garvey Drilling Company, Contractor

Location: NE NE SW

Drilling Commenced: March 9, 1952

County: Stafford

Drilling Completed: March 19, 1952

Casing Record: 8-5/8" at 245' W/190 sacks

5-1/2" @ 3599' W/100 sacks

R.T.D.: 3600'

T.D. 3626 D.F.

Elevation 1908 D.F.

Figures below indicate bottom of formation:

248	Sand & Blue Shale
370	Grey Shale & Sand.
690	Red Bed & Sand
782	Shale & Shells
806	Anhydrite
1450	Shale & Shells
1575	Lime & Shale
1745	Brown Lime
2005	Lime & Shale
3220	Shale & Shells
2434	Lime, Shale & Shells
2670	Shale
3130	Shale & Lime
3145	Lime
3220	Lime & Shale
3320	Shale & Shells
3330	Lime & Shale
3491	Lime
3504	Shale & Lime
3600	Lime
3600'	R.T.D.

Anhydrite: 782 BB. 2' D.F.

Heebner	3193
Toronto	3212
Br. Le.	3314
Lans	3326
Cg. Shy.	3560
Arb.	3595

Radium zln, dol. sli. odor & S.S.P.O. good stain in dry spls.

D.D. 1 1/2 BOPH: D.D. 3612 no iacr.  
P.B. 3602: 100 acid 1/2 BOPH, 2000 acid no increase: D.D. 3626 2 1/2 BWPH  
P.B. & perf. (12) 3485-88, 500 acid 1/2 BWPH & scum of oil

PRODUCTION: D. & A.

**PLUGGING**  
FILE SEC 8 7 21 R 13W  
BOOK PAGE 7 LINE 19

## THE EL DORADO REFINING COMPANY

EL DORADO, KANSAS

DRILLER'S LOG NO. 1 DIAMOND

El Dorado Refining Company, lease owner. Section 8, Twp. 215, Rge. 13W.

Garvey Drilling Company, Contractor Location: NE NE SW

Drilling Commenced: March 9, 1952 County: Stafford

Drilling Completed: March 19, 1952

Casing Record: 8-5/8" at 245' W/190 sacks R.T.D.: 3600'  
 5-1/2" @ 3599' W/100 sacks T.D. 3626 D.F.  
 Elevation 1908 D.F.

Figures below indicate bottom of formation:

248	Sand & Blue Shale	
370	Grey Shale & Sand.	
690	Red Bed & Sand	Anhydrite: 782 BB. 2' D.F.
782	Shale & Shells	
806	Anhydrite	Heebner 3193
1450	Shale & Shells	Toronto 3212
1575	Lime & Shale	Br. Le. 3314
1745	Brown Lime	Lans 3326
2005	Lime & Shale	Cg. Shy. 3560
3220	Shale & Shells	Arb. 3595
2434	Lime, Shale & Shells	
2670	Shale	Radium zln, dol. sli. odor & S.S.P.O. good stain in dry spls.
3130	Shale & Lime	
3145	Lime	
3220	Lime & Shale	D.B. 1 1/2 BOPH: D.D. 3612 no iacr.
3320	Shale & Shells	P.B. 3602: 100 acid 1/2 BOPH, 2000
3330	Lime & Shale	acid no increase: D.D. 3626 2 1/2 BOPH
3491	Lime	P.B. & perf. (12) 3485-88, 500 acid
3564	Shale & Lime	1/2 BOPH & scum of oil
3600	Lime	
3600'	R.T.D.	PRODUCTION: D. & A.

RECEIVED  
 STATE CORPORATION COMMISSION  
 APR 23 1952

CONSERVATION DIVISION  
 Wichita, Kansas