


WELL PLUGGING RECORD

Give All Information Completely  
Make Required Affidavit  
Call or Deliver Report to:  
Conservation Division  
State Corporation Commission  
800 Bittling Building  
Wichita, Kansas

NORTH

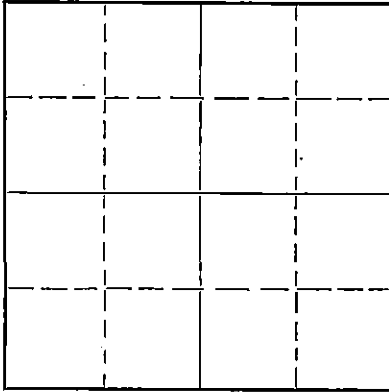

Locate well correctly on above  
Section Plat

Stafford County. Sec. 8 Twp. 21 Rge. (E) 13 (W)  
Location as "NE/CNW $\frac{1}{4}$ /SW $\frac{1}{4}$ " or footage from lines Gen. NE SE NW  
Lease Owner Cities Service Oil Company  
Lease Name Reed "B" Well No. 2  
Office Address Bartlesville, Oklahoma  
Character of Well (completed as Oil, Gas or Dry Hole) Dry Hole  
Date well completed April 19, 1952  
Application for plugging filed April 19, 1952  
Application for plugging approved April 19, 1952  
Plugging commenced April 19, 1952  
Plugging completed April 19, 1952  
Reason for abandonment of well or producing formation Dry Hole

If a producing well is abandoned, date of last production ---- 19  
Was permission obtained from the Conservation Division or its agents before plugging was commenced? Yes

Name of Conservation Agent who supervised plugging of this well M. A. Rives  
Producing formation ---- Depth to top ---- Bottom ---- Total Depth of Well 3665 Feet  
Show depth and thickness of all water, oil and gas formations.

OIL, GAS OR WATER RECORDS

CASING RECORD

Formation	Content	From	To	Size	Put In	Pulled Out
				8-5/8"	380'	None

Describe in detail the manner in which the well was plugged, indicating where the mud fluid was placed and the method or methods used in introducing it into the hole. If cement or other plugs were used, state the character of same and depth placed, from ---- feet to ---- feet for each plug set.

3665' to 350', mud.  
350' to 300', wood plug and 15 sacks cement.  
300' to 35', mud.  
35' to 30', wood plug and hulls.  
30' to base of cellar, 10 sacks cement.

5-3-52  
MAY 2 1952  
CONSERVATION DIVISION  
Wichita, Kansas

(If additional description is necessary, use BACK of this sheet)

Correspondence regarding this well should be addressed to R. C. Cooper  
Address Box 751  
Great Bend, Kansas

STATE OF Kansas, COUNTY OF Barton, ss.  
V. M. Conover (employee of owner) or ~~conservation agent~~


being first duly sworn on oath, says: That I have knowledge of the facts, statements, and matters herein contained and the log of the above-described well as filed and that the same are true and correct. So help me God.

(Signature) *V. M. Conover*  
Box 751, Great Bend, Kansas  
(Address)

SUBSCRIBED AND SWORN TO before me this 21st day of April, 1952

*W. E. Smith*  
Notary Public.

My commission expires March 12, 1955.

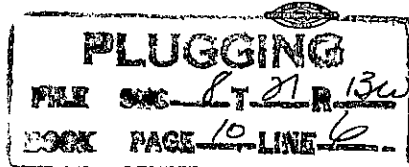

# WELL RECORD

Company Cities Service Oil Co. Well No. 2 Farm Reed "B"  
 Location 2310' East and 1650' South of NW Corner Sec. 8 T. 21 R. 13W  
 Elevation 1904 (1902 Gr.) County Stafford State Kansas  
 Drlg. Comm. April 6, 1952 Contractor R. W. Rine Drilling Company  
 Drlg. Comp. April 16, 1952 Acid None  
 T. D. 3665' Initial Prod. Dry Hole; Plugged and Abandoned 4-19-52.

CASING RECORD:

8-5/8" @ 370' cem. 250 sx cement

FORMATION RECORDED:

shale	0-380
red rock, sand & shale	785
anhydrite	795
shale & shells	1435
salt	1510
lime & shale	1700
lime	1865
lime & shale	2135
lime, shale & shells	2290
shale & lime	2440
lime & shale	2640
shale & shells	2760
shale	2970
lime	3260
lime & shale	3320
lime	3565
lime & shale	3608
cored: Rec. 1 1/2' shale and dolomite	3611
cored: Rec. 5' dolomite and shale	3617
cored: Rec. 4' shale and dolomite	3622
cored: Rec. 5' dolomite and shale	3627
lime	3665 T. D.

Heebner	3191'
Brown Limestone	3309'
Lansing	3321'
Kros. Simpson	3577'
Simpson	3581'
Arbuckle	3602'
Penetration	63'
Total Depth	3665'

STRO:	500'	1°
	1000'	1°
	1500'	1°
	2000'	0°
	2500'	0°
	3000'	1°

Drill stem test 3335-60, open 1 hr.,  
recovered 20' mud; 15 min. B. H. P. 0 1/2.

Drill stem test 3614-37, open 1 hr.,  
recovered 60' mud with few specks  
oil; B. H. P. 740# in 15 mins.

RECEIVED  
STATE CORPORATION COMMISSION

MAY - 3 1952

CONSERVATION DIVISION

PLUGGING

FILE SEC 8 T 21 R 13W  
BOOK PAGE 10 LINE 6