

WELL PLUGGING RECORD

Give All Information Completely
Make Required Affidavit
Mail or Deliver Report to:
Conservation Division
State Corporation Commission
800 Bittling Building
Wichita, Kansas

Stafford County, Sec. 8 Twp 21 Rge. (E) 13 (W)

Location as "NE/CNW%SW%" or footage from lines C S/2 SE SW

Lease Owner Donald T. Ingling, et al

Lease Name Dimond Well No. 1

Office Address 611 Orpheum Bldg., Wichita, 2, Kansas

Character of Well (completed as Oil, Gas or Dry Hole) Dry Hole

Date well completed June 13, 1953

Application for plugging filed June 13, 1953

Application for plugging approved June 13, 1953


Plugging commenced June 13, 1953

Plugging completed June 13, 1953

Reason for abandonment of well or producing formation Dry

If a producing well is abandoned, date of last production _____ 19__

Was permission obtained from the Conservation Division or its agents before plugging was commenced? Yes

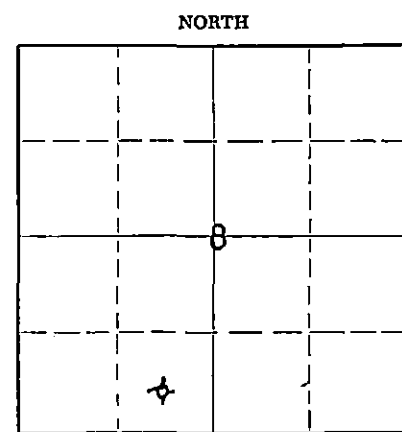

Locate well correctly on above Section Plat

Name of Conservation Agent who supervised plugging of this well C. D. Stough, Great Bend, Kansas

Producing formation _____ Depth to top _____ Bottom _____ Total Depth of Well 366 1/2 Feet

Show depth and thickness of all water, oil and gas formations.

OIL, GAS OR WATER RECORDS

CASING RECORD

FORMATION	CONTENT	FROM	TO	SIZE	PUT IN	PULLED OUT
				8 5/8"	290'	None

Describe in detail the manner in which the well was plugged, indicating where the mud fluid was placed and the method or methods used in introducing it into the hole. If cement or other plugs were used, state the character of same and depth placed, from _____ feet to _____ feet for each plug set.

Circulated 1 hour, laid down one-half drill pipe. Circulated 1 hour, laid down balance of drill pipe. Put bottom plug at 290 feet, mud and 20 sacks of cement, then mud to 35' and set top plug, then 10 sacks cement at surface.

(If additional description is necessary, use BACK of this sheet)

Name of Plugging Contractor D. T. Ingling

Address 611 Orpheum Building, Wichita 2, Kansas

STATE OF KANSAS, COUNTY OF SEDGWICK, ss.

D. T. Ingling (employee of owner) or (owner or operator) of the above-described well, being first duly sworn on oath, says: That I have knowledge of the facts, statements, and matters herein contained and the log of the above-described well as filed and that the same are true and correct. So help me God.

(Signature) D. T. Ingling

611 Orpheum Bldg., Wichita 2, Kansas
(Address)

SUBSCRIBED AND SWORN TO before me this 15th day of June, 1953

W. H. Black
Notary Public.

My commission expires February 27, 1956

PLUGGING
FILE SEC 8 T 21 R 13W
BOOK PAGE 107 LINE 13

RECEIVED
JUN 15 1953
6-16-53
DIVISION

WELL LOG - DIMOND NO. 1

Donald T. Ingling, et al, Lease Owners
 Donald T. Ingling, Contractor
 Commenced: 5-25-53
 Completed: 6-13-53
 Total Depth: 3664'
 Casing: 8 5/8" - 290' (250 sacks cement)

Section 8-21-13W
 Location: C S/2 SE SW
 County: Stafford, Kansas
 Production: Dry
 Elevation: 1905' DF

Figures below indicate bottom formation

80	Sand	2875	Lime and shale
110	Iron pyrite and sand	2925	Lime
150	Sand	2975	Lime
290	Shale and shells	3020	Lime
380	Shale and sand	3060	Lime
645	Red rock	3090	Lime
785	Red rock and shale	3110	Lime
810	Anhydrite	3190	Lime
1010	Shale and shells	3225	Lime
1280	Shale and shells	3270	Lime
1560	Shale and shells	3290	Lime and shale
1685	Lime	3320	Lime and shale
1770	Lime	3350	Lime
1860	Lime	3375	Lime
1925	Lime - cherty streaks	3400	Lime
1995	Lime and shale	3420	Lime
2100	Lime and shale	3450	Lime
2160	Lime and shale streaks	3485	Lime
2185	Lime and shale	3510	Lime
2275	Lime and shale	3535	Lime
2390	Lime and shale	3560	Lime
2485	Lime and shale	3585	Lime
2575	Lime and shale	3605	Lime
2655	Lime and shale	3625	Simpson
2735	Lime and shale	3640	Simpson shale
2805	Lime and shale	3643	Top Arbuckle
		3660	Lime and shale
		3664	Arbuckle
		3664	Total Depth

I certify this is a true and correct log of the above mentioned well.

D. T. Ingling
 D. T. Ingling

STATE OF KANSAS)
) SE
 COUNTY OF SEDGWICK)

Subscribed and sworn to before me, a Notary Public in said County and State.

M. E. Beach
 Notary Public

My commission expires February 27, 1956

NOTARY PUBLIC COMMISSION
 JUN 13 1953

CONSERVATION DIVISION
 Wichita, Kansas

PLUGGING
 FILE SEC 8 T 21 R 13W
 BOOK PAGE 107 LINE 43