

STATE OF KANSAS
STATE CORPORATION COMMISSION

Give All Information Completely
Make Required Affidavit
Mail or Deliver Report to:
Conservation Division
State Corporation Commission
211 No. Broadway
Wichita, Kansas

WELL PLUGGING RECORD

Stafford County. Sec. 8 Twp. 21S Rge. 13W (E) (W)

Location as "NE/CNW/SW" or footage from lines SE SW SW

Lease Owner L K Parrish

Lease Name Dimond Well No. 1

Office Address 714 Fourth Natl Bank Bldg., Wichita, Kansas

Character of Well (completed as Oil, Gas or Dry Hole) Dry & abandoned

Date well completed September 11 19 65

Application for plugging filed September 10 19 65

Application for plugging approved September 10 19 65


Plugging commenced September 11 19 65

Plugging completed September 11 19 65

Reason for abandonment of well or producing formation Too low structurally

If a producing well is abandoned, date of last production _____ 19 _____

Was permission obtained from the Conservation Division or its agents before plugging was commenced? yes

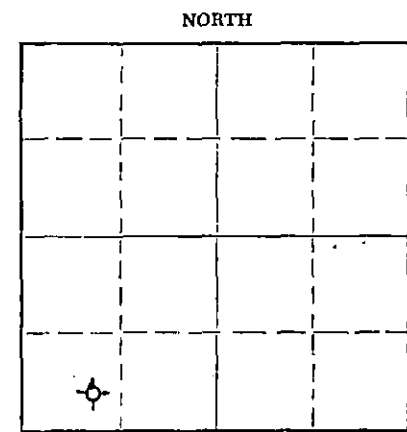

Locate well correctly on above Section Plat

Name of Conservation Agent who supervised plugging of this well Archie V Elving

Producing formation _____ Depth to top _____ Bottom _____ Total Depth of Well 3680 Feet

Show depth and thickness of all water, oil and gas formations.

OIL, GAS OR WATER RECORDS

CASING RECORD

FORMATION	CONTENT	FROM	TO	SIZE	PUT IN	PULLED OUT
				8-5/8"	326'	none

Describe in detail the manner in which the well was plugged, indicating where the mud fluid was placed and the method or methods used in introducing it into the hole. If cement or other plugs were used, state the character of same and depth placed, from _____ feet to _____ feet for each plug set.

Filled hole with heavy mud to 320'. Set plug. Put in 1/2 sack hulls and 25 sacks cement. Filled hole with heavy mud to 40'. Set plug. Filled to top with 1/2 sack hulls and 25 sacks cement.

RECEIVED
STATE CORPORATION COMMISSION

NOV 2 1965

11-2-1965

CONSERVATION DIVISION
Wichita, Kansas

(If additional description is necessary, use BACK of this sheet)

Name of Plugging Contractor C-G Drilling Co.

Address 107 Rule Building, Wichita, Kansas

STATE OF Kansas, COUNTY OF Sedgwick, ss.

G. F. Galloway (employee of owner) or (~~owner or operator~~) of the above-described well, being first duly sworn on oath, says: That I have knowledge of the facts, statements, and matters herein contained and the log of the above-described well as filed and that the same are true and correct. So help me God.


(Signature) G. F. Galloway

107 Rule Building, Wichita, Kansas

(Address)

Subscribed and Sworn to before me this 13th day of September 19 65

Wicky Jacobs
Notary Public.

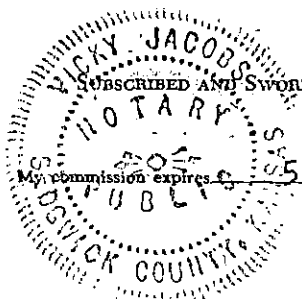

W E L L L O G

OPERATOR: L. K. PARRISH

WELL NAME: DIMOND #1 LOCATION: SE SW SW SEC. 8-21S-13W

COUNTY: STAFFORD STATE: KANSAS

WELL COMMENCED: 9/1/65 WELL COMPLETED: 9/11/65

ELEVATION: 1923 K.B. TOTAL DEPTH: 3680'

PRODUCTION: Dry & abandoned RIG NO: 2

CASING - 8-5/8": 326' of new 20# (8 jts.)

5-1/2": _____

All Measurements taken from the top of rotary bushing.

FROM	TO	FORMATION	DEVIATION FROM VERTICAL	REMARKS:
0	110	Sand		
110	127	Hard Sand		
127	430	Shale-Sand		
430	810	Shale-Red Bed		
810	832	Anhydrite	1000' - 1/4°	
832	1550	Shale-Shells	1500' - 1/2°	
1550	3375	Lime-Shale	2000' - 1/2°	
3375	3425	Lime	2500' - 1/2°	
3425	3485	Lime-Shale	3000' - 1/2°	
3485	3570	Lime		
3570	3625	Lime-Chert		
3625	3680	Lime		
		Anhydrite	810	
		Wellington		
		Hollemberg		
		Herington		
		Krider		
		Winfield		
		Towanda		
		Fort Riley		
		Florence		
		Wreford		
		Cottonwood		
		Neva		
		Foraker		
		Tarkio		
		Elmont		
		Howard		
		Topeka		
		Deercreek		
		Heebrier	3232	MississDOT #1 3674-3680
		Toronto		Chester
		Douglas		St. Genev.
		Iatan		St. Louis
		Stalnaker		Warsaw
		Iola		Misner
		Layton		Kinderhook
		Lansing	3365	Hunton
		Kansas City		Maquoketa
		Base K. C.	3570	Viola 3589
		Marmaton		Simpson 3620
		Pawnee		Arbuckle 3672
		Fort Scott		Regan
		Cherokee		Precam.
		Bartles.		
		Conglo.		
		Morrow		
		Kearny		

RECEIVED
STATE CORPORATION COMMISSION

NOV 2 1965

CONSERVATION DIVISION
Wichita, Kansas

STATE OF KANSAS
COUNTY OF SEDGWICK) SS:

The undersigned hereby certifies that to the best of his knowledge and belief, the above facts are true and correct.

C-G DRILLING CO.

By [Signature]

SUBSCRIBED AND SWORN TO, BEFORE ME, This 14th day of September, 1965.

My comm. exp: May 20, 1967

[Signature]
Vicky Jacobs - Notary Public

