


Give All Information Completely
Make Required Affidavit
Mail or Deliver Report to:
Conservation Division
State Corporation Commission
212 North Market, Insurance Bldg.
Wichita, Kansas

15.185.10630.0001

WELL PLUGGING RECORD

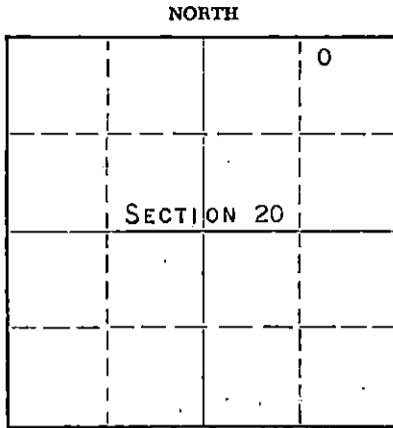

Locate well correctly on above Section Plat

STAFFORD County. Sec 20 Twp 21S Rge 13W (#) W (W)
Location as "NE/CNW/SW" or footage from lines NW NE NE
Lease Owner PETROLEUM, INC.
Lease Name HAZEL W.W.D. SYSTEM (KOOPTMAN #3) Well No. _____
Office Address ROUTE 2, GREAT BEND, KANSAS
Character of Well (completed as Oil, Gas or Dry Hole) SALT WATER DISPOSAL
Date well completed OCTOBER 23 19 51
Application for plugging filed APRIL 15 19 60
Application for plugging approved APRIL 18 19 60
Plugging commenced APRIL 18 19 60
Plugging completed APRIL 19 19 60
Reason for abandonment of well or producing formation CASING COLLAPSED
NO LONGER ABLE TO DISPOSE WATER
If a producing well is abandoned, date of last production --- 19 _____
Was permission obtained from the Conservation Division or its agents before plugging was commenced? YES

Name of Conservation Agent who supervised plugging of this well FRANK BROADFOOT, ST. JOHN, KANSAS
Producing formation --- Depth to top --- Bottom --- Total Depth of Well 4224 Feet
Show depth and thickness of all water, oil and gas formations.

OIL, GAS OR WATER RECORDS

CASING RECORD

FORMATION	CONTENT	FROM	TO	SIZE	PUT IN	PULLED OUT
ARBUCKLE	SALT WATER (DISPOSED)	4061.68'	4224'	8-5/8"	202.56'	NONE
				5-1/2"	4061.68'	314'

Describe in detail the manner in which the well was plugged, indicating where the mud fluid was placed and the method or methods used in introducing it into the hole. If cement or other plugs were used, state the character of same and depth placed, from _____ feet to _____ feet for each plug set.

SET PLUG IN COLLAPSED CASING AT 2940' WITH 20' SAND AND 5 SACKS CEMENT, MUDDED UP WITH HEAVY MUD TO 200' AND MADE SOLID ROCK BRIDGE, PLACED 20 SACKS CEMENT ONTO ROCK BRIDGE. MUDDED UP WITH HEAVY MUD TO 40' AND MADE SOLID ROCK BRIDGE, PLACED 10 SACKS CEMENT ONTO PLUG TO BASE OF WELL CELLAR.

RECEIVED
STATE CORPORATION COMMISSION
MAY 2 1960
CONSERVATION DIVISION
Wichita, Kansas

(If additional description is necessary, use BACK of this sheet)

Name of Plugging Contractor SOUTHWESTERN CASING PULLING COMPANY, INC.
Address BOX 364, GREAT BEND, KANSAS

STATE OF KANSAS COUNTY OF BARTON, ss.
DON SEARLE (employee of owner) or (~~owner~~) of the above-described well, being first duly sworn on oath, says: That I have knowledge of the facts, statements, and matters herein contained and the log of the above-described well as filed and that the same are true and correct. So help me God.

(Signature) Don Searle
ROUTE 2, GREAT BEND, KANSAS
(Address)

Subscribed and Sworn to before me this 25TH day of APRIL, 19 60

My commission expires APRIL 14, 1963 Arthur J. miles Notary Public.



15.185.10630.0001

PETROLEUM, INC.

ROUTE 2

GREAT BEND, KANSAS

APRIL 15, 1960

SOUTHWESTERN CASING PULLING COMPANY, INC.

MR. W. H. HORNER

BOX 364

GREAT BEND, KANSAS

DEAR MR. HORNER:


THE FOLLOWING IS INFORMATION YOU WILL NEED IN THE PIPE PULLING AND PLUGGING OF ONE OF OUR ABANDONED WASTE WATER DISPOSAL WELLS:

WELL AND DESCRIPTION:	HAZEL W.W.D.S. (Koopman #3) NW NE NE, SEC. 20-21s-13W STAFFORD COUNTY, KANSAS
ROTARY TOTAL DEPTH:	4062.68'
PRESENT TOTAL DEPTH:	2940' PIPE COLLAPSED AT THIS POINT
SURFACE CASING:	8-5/8" OD 25.55# SET AT 202.56' WITH 175 SACKS CEMENT, 2% CC, 2% GEL. CEMENT CIRCULATED.
PRODUCTION STRING:	5-1/2" OD 14# J-55 CASING SET AT 4061.68' WITH 200 SACKS CEMENT, 1% SLURRY, 1/2% DOWELL FLAKES .12-10-50
TOP OF CEMENT:	SQUEEZED AT 610', HAD BRADEN HEAD OPEN, BUT DID NOT GET CIRCULATION. DO NOT KNOW TOP OF CEMENT

PLEASE NOTIFY US WHEN YOU WILL MOVE ON THIS LOCATION.

YOURS VERY TRULY,

PETROLEUM, INC.

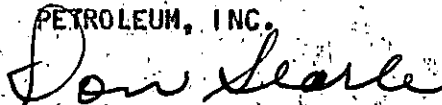

DON SEARLE
DIST. PROD. SUPT.

DS/PO

CC: MR. FRANK BROADFOOT ✓
222 S. MAIN ST. JOHN, KANSAS

MR. BILL BUCHHOLZ
GREAT BEND, KANSAS

MR. MONTE CHADD
GREAT BEND, KANSAS

MR. C. J. WILTSE
GREAT BEND, KANSAS

MR. HAROLD YOUNG
GREAT BEND, KANSAS

FILE

RECEIVED
STATE CORPORATION COMMISSION
APR 26 1960
CONCRETE DIVISION