

CARD MUST BE TYPED

State of Kansas
NOTICE OF INTENTION TO DRILL
(see rules on reverse side)

CARD MUST BE SIGNED

Starting Date: OCTOBER 26 1984
month day year

API Number 15- 009-23,765-00-00

OPERATOR: License # 5430
Name ENERGY THREE, INC.
Address P.O. Box 1505
City/State/Zip GREAT BEND, KS. 67530
Contact Person DOUGLAS MEYER
Phone AC316-792-5968

CENT. S/2 NE NW Sec 26 Twp 16 S, Rge 12 East
(location) West

4290 Ft North from Southeast Corner of Section
3300 Ft West from Southeast Corner of Section
(Note: Locate well on Section Plat on reverse side)

CONTRACTOR: License # 5836
Name BIG THREE DRILLING, INC.
City/State P.O. Box 52, GORHAM, KS. 67640

Nearest lease or unit boundary line 660 feet.
County BARTON
Lease Name DOLECHEK "B" Well# 2

Domestic well within 330 feet: yes no
Municipal well within one mile: yes no

Well Drilled For: Well Class: Type Equipment:
 Oil Swd Infield Mud Rotary
 Gas Inj Pool Ext. Air Rotary
 OWWO Expl Wildcat Cable

Depth to Bottom of fresh water 200 feet
Lowest usable water formation DAKOTA
Depth to Bottom of usable water 350 feet
Surface pipe by Alternate: 1 2
Surface pipe to be set 350 feet
Conductor pipe if any required _____ feet
Ground surface elevation _____ feet MSL
This Authorization Expires 4-22-85
Approved By 10-22-84 *[Signature]*

If OWWO: old well info as follows:

Operator _____
Well Name _____
Comp Date _____ Old Total Depth _____
Projected Total Depth 3500 feet
Projected Formation at TD ARBUCKLE
Expected Producing Formations ARBUCKLE

I certify that we will comply with K.S.A. 55-101, et seq., plus eventually plugging hole to K.C.C. specifications.


Date 10-19-84 Signature of Operator or Agent Douglas P. Meyer Title EXEC. VICE-PRESIDENT
Form C-1 4/84

MHC/MONE 10/22/84

Must be filed with the K.C.C. five (5) days prior to commencing well
 This card void if drilling not started within six (6) months of date received by K.C.C.

Important procedures to follow:

**A Regular Section of Land
 1 Mile = 5,280 Ft.**

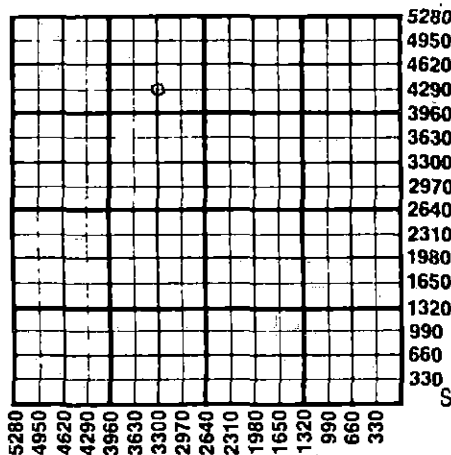

1. Notify District office before setting surface casing.
2. Set surface casing by circulating cement to the top.
3. File completion forms ACO-1 with K.C.C. within 90 days of well completion, following instructions on ACO-1, side 1, and including copies of wireline logs.
4. Notify District office 48 hours prior to old well workover or re-entry.
5. Prior to plugging, prepare a plugging plan, then obtain agreement from the appropriate district office for an approved plugging plan.
6. Submit plugging report (CP-4) to K.C.C. after plugging is completed.
7. Obtain an approved injection docket number before disposing of salt water.
8. Notify K.C.C. within 10 days when injection commences or terminates.

9. If an alternate 2 completion, cement in the production pipe from below any usable water to surface within 120 days of spud date.

STATE CORPORATION COMMISSION

OCT 22 1984
 10-22-84
 CONSERVATION DIVISION
 Wichita, Kansas

State Corporation Commission of Kansas
 Conservation Division
 200 Colorado Derby Building
 Wichita, Kansas 67202
 (316) 263-3238