

CARD MUST BE TYPED

State of Kansas
NOTICE OF INTENTION TO DRILL
(see rules on reverse side)

CARD MUST BE SIGNED

Starting Date: September 13, 1984
month day year

API Number 15- 055-20,561.0000

OPERATOR: License # 5652 5313
Name Mustang Drilling & Exploration, Inc. & P. O. Drawer 1609, Gt. Bend, KS
Address 200 W. Douglas, Suite 800
City/State/Zip Wichita, Kansas 67202
Contact Person Bill C. Romig
Phone 316-267-8011

East
C SW NW Sec 8 Twp 21 S, Rge 33 West
(location)

3300 Ft North from Southeast Corner of Section
4620 Ft West from Southeast Corner of Section
(Note: Locate well on Section Plat on reverse side)

CONTRACTOR: License # 5652
Name Mustang Drilling & Exploration, Inc.
City/State P. O. Drawer 1609, Gt. Bend, KS

Nearest lease or unit boundary line 660 feet.
County Finney
Lease Name Wampler Well# 1-8

Well Drilled For: Well Class: Type Equipment:
 Oil Swd Infield Mud Rotary
 Gas Inj Pool Ext. Air Rotary
 OWWO Expl Wildcat Cable

Domestic well within 330 feet: yes no
Municipal well within one mile: yes no

If OWWO: old well info as follows:
Operator
Well Name
Comp Date Old Total Depth
Projected Total Depth 4825 feet
Projected Formation at TD Mississippi
Expected Producing Formations Cherokee

Depth to Bottom of fresh water 200 feet
Lowest usable water formation Dakota
Depth to Bottom of usable water 1,000 feet
Surface pipe by Alternate: 1 2
Surface pipe to be set 400 feet
Conductor pipe if any required 0 feet
Ground surface elevation est. 2920 feet MSL
This Authorization Expires 2-7-85

I certify that we will comply with K.S.A. 55-101, et seq., plus eventually plugging hole to C.C. specifications.

Date 8 - 7 - 84 Signature of Operator or Agent [Signature]

Approved By [Signature] Title Exploration Manager


mhc/140HE 8/7/84 Form C-1 4/84

Must be filed with the K.C.C. five (5) days prior to commencing well
This card void if drilling not started within six (6) months of date received by K.C.C.

8-7-84

Important procedures to follow:

1. Notify District office before setting surface casing.
2. Set surface casing by circulating cement to the top.
3. File completion forms ACO-1 with K.C.C. within 90 days of well completion, following instructions on ACO-1, side 1, and including copies of wireline logs.
4. Notify District office 48 hours prior to old well workover or re-entry.
5. Prior to plugging, prepare a plugging plan, then obtain agreement from the appropriate district office for an approved plugging plan.
6. Submit plugging report (CP-4) to K.C.C. after plugging is completed.
7. Obtain an approved injection docket number before disposing of salt water.
8. Notify K.C.C. within 10 days when injection commences or terminates.
9. If an alternate 2 completion, cement in the production pipe from below any usable water to surface within 120 days of spud date.

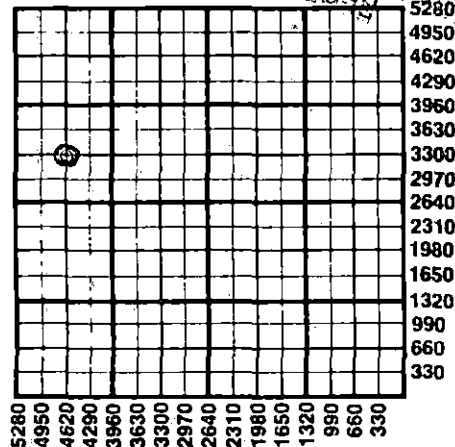

State Corporation Commission of Kansas
Conservation Division
200 Colorado Derby Building
Wichita, Kansas 67202
(316) 263-3238