

CARD MUST BE TYPED

State of Kansas
NOTICE OF INTENTION TO DRILL

CARD MUST BE SIGNED

CORRECTION

(see rules on reverse side)

CORRECTION

Starting Date: 2nd 27 85
month day year

API Number 15- 097-2116-00-00³⁵⁸⁵

OPERATOR: License # 5171
Name TXO Production Corp.
Address 200 W. Douglas, Suite 300
City/State/Zip Wichita, KS 67202
Contact Person Gary Wurdeman
Phone 316-265-9441

*137' E. W/2 NW NW Sec. 10. Twp 28 S, Rge 16. East West
(location)
4620 Ft North from Southeast Corner of Section
* 4813 Ft West from Southeast Corner of Section
(Note: Locate well on Section Plat on reverse side)

CONTRACTOR: License # 6165
Name FWA Drilling Co., Inc.
City/State Yukon, OK 73085-0980

Nearest lease or unit boundary line 427 feet.
County Kiowa
Lease Name * RINKEL 'A' Well# 1
Domestic well within 330 feet: yes no
Municipal well within one mile: yes no

Well Drilled For: Well Class: Type Equipment:
 Oil Swd Infield Mud Rotary
 Gas Inj Pool Ext. Air Rotary
 OWWO Expl Wildcat Cable

Depth to Bottom of fresh water 100 feet
Lowest usable water formation Unknown
Depth to Bottom of usable water 200 feet
Surface pipe by Alternate: 1 2
Surface pipe to be set 400 feet
Conductor pipe if any required 0 feet
Ground surface elevation TBD feet MSL
This Authorization Expires 8-26-85
Approved By 2-26-85

If OWWO: old well info as follows:
Operator
Well Name
Comp Date Old Total Depth
Projected Total Depth 4850 feet
Projected Formation at TD Viola
Expected Producing Formations Viola

I certify that we will comply with K.S.A. 55-101, et seq., plus eventually plugging hole to K.C.C. specifications. ~~xxxx~~ W/2 NW NW 4950 FE

Date 3-4-85 Signature of Operator or Agent *Jerry W. Collins* Title Drlg & Completion Engr #3
Form C-1 4/84

Must be filed with the K.C.C. five (5) days prior to commencing well
 This card void if drilling not started within six (6) months of date received by K.C.C.


CONSERVATION DIVISION
 WICHITA, KANSAS

MAR 5 1985
 3-5-85

STATE CORPORATION COMMISSION
 A Regulatory Section of Land
 1 Mile = 5,280 Ft.

Important procedures to follow:

1. Notify District office before setting surface casing.
2. Set surface casing by circulating cement to the top.
3. File completion forms ACO-1 with K.C.C. within 90 days of well completion, following instructions on ACO-1, side 1, and including copies of wireline logs.
4. Notify District office 48 hours prior to old well workover or re-entry.
5. Prior to plugging, prepare a plugging plan, then obtain agreement from the appropriate district office for an approved plugging plan.
6. Submit plugging report (CP-4) to K.C.C. after plugging is completed.
7. Obtain an approved injection docket number before disposing of salt water.
8. Notify K.C.C. within 10 days when injection commences or terminates.
9. If an alternate 2 completion, cement in the production pipe from below any usable water to surface within 120 days of spud date.

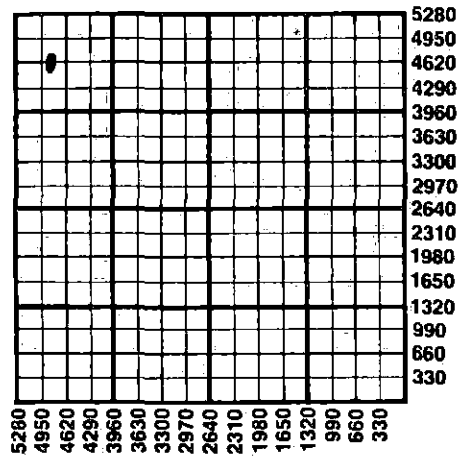

State Corporation Commission of Kansas
 Conservation Division
 200 Colorado Derby Building
 Wichita, Kansas 67202
 (316) 263-3238