

WELL PLUGGING RECORD

OR


FORMATION PLUGGING RECORD

Strike out upper line when reporting plugging of formations.

STATE OF KANSAS STATE CORPORATION COMMISSION

Give All Information Completely Make Required Affidavit Mail or Deliver Report to: Conservation Division State Corporation Commission 800 Bittling Building Wichita, Kansas

Stafford County. Sec. 2 Twp. 21 Rge. 11 (W) Location as "NE 1/4 NW 1/4 SW 1/4" or footage from lines C SE SE SW Lease Owner Donald T. Ingling, et al Lease Name Rugan Well No. 1 Office Address 708 Fourth Nat'l Bldg., Wichita, Kansas Character of Well (completed as Oil, Gas or Dry Hole) Dry Hole Date well completed 1/18 19 49 Application for plugging filed 1/18 19 49 Application for plugging approved 1/18 19 49 Plugging commenced 1/18 19 49 Plugging completed 1/18 19 49 Reason for abandonment of well or producing formation

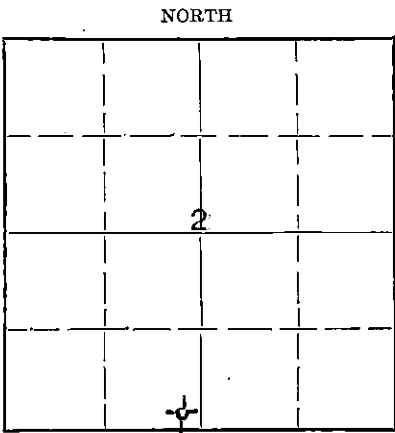

Locate well correctly on above Section Plat

If a producing well is abandoned, date of last production 19... Was permission obtained from the Conservation Division or its agents before plugging was commenced? Yes

Name of Conservation Agent who supervised plugging of this well Mr. C. D. Stough, Great Bend, Kansas Producing formation Depth to top Bottom Total Depth of Well 3496 Feet Show depth and thickness of all water, oil and gas formations.

OIL, GAS OR WATER RECORDS

CASING RECORD

Table with 7 columns: Formation, Content, From, To, Size, Put In, Pulled Out. Row 1: 8-5/8, 315', None

Describe in detail the manner in which the well was plugged, indicating where the mud fluid was placed and the method or methods used in introducing it into the hole. If cement or other plugs were used, state the character of same and depth placed, from... feet to... feet for each plug set.

Jetted pits and circulated heavy mud thirty minutes - laid down 1700' drill pipe and filled hole with heavy mud - laid down balance drill pipe and filled hole with heavy mud to 200 feet - placed wood plug at 200 feet and run 15 sacks cement on this plug - filled hole with heavy mud to 30 feet - second wood plug, then cemented to base of cellar.

RECEIVED Conservation Div. JAN 21 1949 STATE CORPORATION COMMISSION KANSAS

1-21-49

(If additional description is necessary, use BACK of this sheet)

Correspondence regarding this well should be addressed to Donald T. Ingling Address 708 Fourth Nat'l Bldg., Wichita, Kansas

STATE OF Kansas COUNTY OF Sedgwick, ss. I, W. W. Wright (employee of owner) or (owner or operator) of the above-described well,

being first duly sworn on oath, says: That I have knowledge of the facts, statements, and matters herein contained and the log of the above-described well as filed and that the same are true and correct. So help me God.

(Signature) [Signature] 708 Fourth Nat'l Bldg., Wichita, Kans. (Address)

SUBSCRIBED AND SWORN to before me this 20th day of January, 1949 [Signature] Notary Public.

My commission expires Aug 13, 1952

PLUGGING FILE SEC 21 T 21 R 11 W BOOK PAGE 80 LINE 22

WELL LOG RUGAN NO. 1

Ingling & Ripstra - Lease Owners

Sec. 2, Twp. 21, Range 11W

Donald T. Ingling - Contractor

Location: C SE SE SW

Total Depth: 3496' (Rotary)

County: Stafford (Kansas)

Commenced: December 30, 1948

Elevation: 1752 D.F.

Completed: January 18, 1949

Production: Dry

Casing: 315' of 8-5/8"

Figures below indicated bottom of formation:

60	Sand	2735	Lime & Shale
150	Shale & Shells	2820	Lime
460	Red Rock	2865	Lime & Shale
485	Anhydrite	3040	Lime
1335	Shale & Shells	3055	Shale
1665	Shale & Lime	3079	Shale & Lime
1695	Sand	3340	Lime
1740	Lime, Sandy	3419	Conglomerate
1785	Shale & Lime	3470	Simpson
1885	Lime	3490	Arbuckle
		3496	Total Depth

I hereby certify that this is a true and correct log of the above mentioned well.

DONALD T. INGLING

STATE OF KANSAS)
) SS.
SEDGWICK COUNTY)

[Handwritten Signature]

Subscribed and sworn to before me, a Notary Public in said County and State this 20th day of January, 1949.

[Handwritten Signature]
Notary Public

My Commission Expires:

August 13, 1952

PLUGGING
FILE SEC 2 T 21 R 11W
BOOK PAGE 20 LINE 22

JAN 21 1949
STAFFORD CORPORATION
STAFFORD COUNTY
KANSAS