

STATE OF KANSAS
STATE CORPORATION COMMISSION

WELL PLUGGING RECORD

Give All Information Completely
Make Required Affidavit
Mail or Deliver Report to:
Conservation Division
State Corporation Commission
800 Bittling Building
Wichita, Kansas

OR

Strike out upper line
when reporting plugging
off formations.

FORMATION PLUGGING RECORD

Stafford County, Sec. 12 Twp. 21S Rge. 12 (W)

Location as "NE 1/4 NW 1/4 SW 1/4" or footage from lines NW SE SE

Lease Owner: Sohio Petroleum Company

Lease Name: Schrepel Well No. 2

Office Address: Box 609, Russell, Kansas

Character of Well (completed as Oil, Gas or Dry Hole) Dry Hole

Date well completed July 23, 19 47

Application for plugging filed July 24, 19 47

Application for plugging approved July 24, 19 47


Plugging commenced July 24, 19 47

Plugging completed July 25, 19 47

Reason for abandonment of well or producing formation Dry Hole

If a producing well is abandoned, date of last production None 19

Was permission obtained from the Conservation Division or its agents before plugging was commenced? Yes

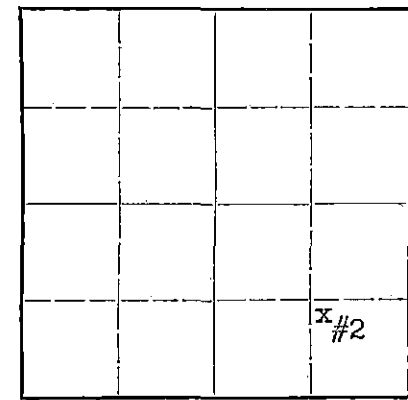

Locate well correctly on above
Section Plat

Name of Conservation Agent who supervised plugging of this well Mr. Herb Kerr

Producing formation None Depth to top Bottom Total Depth of Well 3523 Feet

Show depth and thickness of all water, oil and gas formations.

OIL, GAS OR WATER RECORDS

CASING RECORD

Formation	Content	From	To	Size	Put In	Pulled Out
No commercial oil or gas shows from top to bottom				8 5/8"	593'	None Cemented to top

Describe in detail the manner in which the well was plugged, indicating where the mud fluid was placed and the method or methods used in introducing it into the hold. If cement or other plugs were used, state the character of same and depth placed, from.....feet to.....feet for each plug set.

3523' - 575' - Heavy Mud
575' - 546' - Cement - 15 sacks
546' - 23' - Heavy Mud
23' - 3' - Cement - 10 sacks
3' - 0 - Clay

8-1-1947

STATE CORPORATION COMMISSION
AUG - 1 1947

(If additional description is necessary, use BACK of this sheet)

Correspondence regarding this well should be addressed to Sohio Petroleum Company
Address Box 609, Russell, Kansas

STATE OF Kansas, COUNTY OF Russell, ss.

Doyle Fair (employee of owner) ~~operator~~ of the above-described well,

being first duly sworn on oath, says: That I have knowledge of the facts, statements, and matters herein contained and the log of the above-described well as filed and that the same are true and correct. So help me God.

(Signature) Doyle Fair
Box 68, Russell, Kansas
(Address)

PLUGGING
FILE SEC 12 T 21 R 12W
BOOK PAGE 122 LINE 28

SUBSCRIBED AND SWORN to before me this 31st day of July, 19 47.

My commission expires May 8, 1948.

My commission expires.....

Bernie J. Smith
Notary Public.

FO 28-SP

CONTRACTOR'S VERIFIED LOG

Operator Sohio Petroleum Company Farm Name Schrepel Well No. 2
 Location NW SE SE Section 12-21S-12W
 Pool Name Sandago County Stafford State Kansas
 Commencement Date 7-8-47 Completion Date 7-24-47

LOG OF WELL

Depth		Formation	Deviation from Vertical (Degrees)	Remarks
From	To			
0	5	Cellar		
5	125	Sand		
125	220	Shale		
220	589	Red Beds		
589	620	Anhydrite	Syfo at	8 5/8" Surface Pipe set at 593' and cemented with 300 sacks cement.
620	1110	Shale and Shells	500' OK	
1110	1350	Shale and Salt		
1350	1540	Shale and Shells	1000' OK	
1540	2005	Broken Lime		
2005	2465	Shale and Shells	1500' OK	
2465	2700	Broken Lime		
2700	2760	Shale and Shells	2000' OK	
2760	3070	Lime		
3070	3078	Shale	2500' OK	Core 15' from 3515' to 3530'. 8' recovery.
3078	3090	Lime		
3090	3173	Shale		
3173	3450	Lime		Core from 3530' to 3540' Had 3' recovery.
3450	3516	Shale and Conglomerate		
3516	3525	Arbuckle		Core 3540' to 3545'. No recovery.
		D. & A.		Halliburton Drill Stem Test at 3293'. No shows. Schlumberger test at 3525'.

HALLIBURTON
 STATE CORPORATION
 COMMISSION
 AUG - 1 1947

PLUGGING
 FILE SEC 12-21-R/2W
 BOOK PAGE 22 LINE 28

