

STATE OF KANSAS
STATE CORPORATION COMMISSION


WELL PLUGGING RECORD

Give All Information Completely
Make Required Affidavit
Mail or Deliver Report to:
Conservation Division
State Corporation Commission
212 No. Market
Wichita, Kansas

Stafford County. Sec. 12 Twp. 21S Rge. (X) 12 (W)

Location as "NE/CNW%SW%" or footage from lines NE, SW, NE/4
Lease Owner Clinton Oil Company
Lease Name Hall "A" Well No. 4-D
Office Address 217 No. Water, Wichita, Kansas 67202
Character of Well (completed as Oil, Gas or Dry Hole) Dry Hole
Date well completed November 16 19 69
Application for plugging filed December 23 19 69
Application for plugging approved December 19 19 69
Plugging commenced November 19 19 69
Plugging completed November 19 19 69
Reason for abandonment of well or producing formation Dry Hole

NORTH

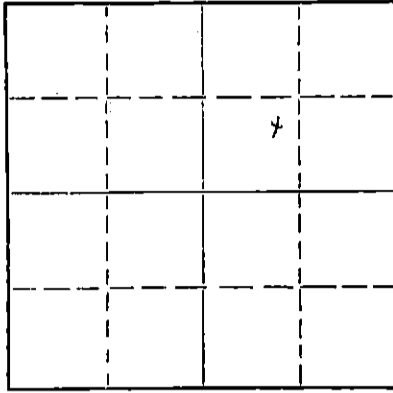

Locate well correctly on above Section Flat

If a producing well is abandoned, date of last production 19
Was permission obtained from the Conservation Division or its agents before plugging was commenced? Yes

Name of Conservation Agent who supervised plugging of this well _____
Producing formation Arbuckle Depth to top 3504 Bottom 3535 Total Depth of Well 3543 Feet
Show depth and thickness of all water, oil and gas formations.

OIL, GAS OR WATER RECORDS

CASING RECORD

FORMATION	CONTENT	FROM	TO	SIZE	PUT IN	PULLED OUT
Lansing	water	3190	3504	8 5/8"	324'	None
Arbuckle	water	3504	3543			

Describe in detail the manner in which the well was plugged, indicating where the mud fluid was placed and the method or methods used in introducing it into the hole. If cement or other plugs were used, state the character of same and depth placed, from _____ feet to _____ feet for each plug set.

Filled hole with heavy rotary mud. At 400', Set plug w/50 sx cement.
Set plug @ 280' w/25 sx cement. Filled hole w/heavy rotary mud and
set plug @ 40' w/10 sx cement. Two sacks of cement in rat hole and
2 sacks cement in mouse hole.

RECEIVED
STATE CORPORATION COMMISSION
JAN 6 1970
CONSERVATION DIVISION
Wichita, Kansas

(If additional description is necessary, use BACK of this sheet)

Name of Plugging Contractor Garvey Drilling Company
Address Route #2, Great Bend

STATE OF KANSAS, COUNTY OF SEDGWICK, ss.
Earl F. Rossman, Jr. (employee of owner) or (~~XXXXXX~~) of the above-described well, being first duly sworn on oath, says: That I have knowledge of the facts, statements, and matters herein contained and the log of the above-described well as filed and that the same are true and correct. So help me God.

(Signature) Earl F. Rossman, Jr.
Proration & Unitization Engineer
217 No. Water, Wichita, Kansas 67202
(Address)

Subscribed and sworn to before me this 30th day of December 19 69
Shirley A. McGuire
Notary Public.

My commission expires December 1973



WELL LOG

15.185.20231.0000

COMPANY Clinton Oil Company

SEC. 12 T. 21S R. 12W

FARM Hall "A"

NO. 4-D

LOC. NE SW NE


TOTAL DEPTH 3543'

COUNTY Stafford, Kansas

COMM. 11-12-69

COMP. 11-19-69

CONTRACTOR Garvey Drilling Company

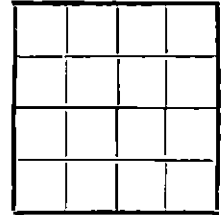

CASING

8 5/8" @ 324' w/325sx

ELEVATION

PRODUCTION D & A

FIGURES INDICATE BOTTOM OF FORMATIONS

- 180' Sand
- 324' Red Bed
- 612' Anhydrite
- 1335' Shale & Shells
- 1660' Lime & Shale
- 2100' Lime
- 2450' Shale & Lime
- 2995' Lime
- 3075' Lime & Shale
- 3105' Shale
- 3204' Lime
- 3457' Lime & Chert
- 3461' Arbuckle
- 3463' Lime
- 3480' Lime & Chert
- 3543' Lime & Chert
- 3543' RTD

RECEIVED
 STATE CORPORATION COMMISSION
 DEC 29 1969
 CONSERVATION DIVISION
 Wichita, Kansas

State of Kansas }
 County of Barton } ss

I, Charlene Marker of Garvey Drilling Company

upon oath state the above and foregoing is a true and correct copy of the log of the Hall "A" No. 4-D well.

Charlene Marker

Subscribed, and sworn to before me this 21st day of November 19 69

My Commission Expires: November 5, 1973

Richard Boop
 NOTARY PUBLIC