

WELL PLUGGING RECORD

STATE OF KANSAS STATE CORPORATION COMMISSION


Give All Information Completely Make Required Affidavit Mail or Deliver Report to: Conservation Division State Corporation Commission 800 Biting Building Wichita, Kansas

FORMATION PLUGGING RECORD

Strike out upper line when reporting plugging of formations.

STAFFORD County. Sec. 33 Twp. 21S Rge. 12 (W)

Location as "NE 1/4 NW 1/4 SW 1/4" or footage from lines SW NE NW Lease Owner Petroleum, Inc. Lease Name Harris Well No. 1 Office Address 100 Derby Building Wichita 2, Kansas Character of Well (completed as Oil, Gas or Dry Hole) Dry hole Date well completed February 27, 1950 Application for plugging filed March 28, 1950 Application for plugging approved March 1, 1950 Plugging commenced March 26, 1950 Plugging completed March 26, 1950 Reason for abandonment of well or producing formation Dry Hole

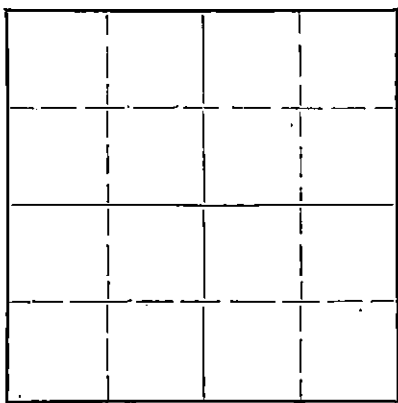

Locate well correctly on above Section Plat

If a producing well is abandoned, date of last production 19. Was permission obtained from the Conservation Division or its agents before plugging was commenced? yes

Name of Conservation Agent who supervised plugging of this well C. D. Stough Producing formation Depth to top Bottom Total Depth of Well 3654 Feet Show depth and thickness of all water, oil and gas formations.

OIL, GAS OR WATER RECORDS

CASING RECORD

Table with 7 columns: Formation, Content, From, To, Size, Put In, Pulled Out. Row 1: 8 5/8", 298.06'

Describe in detail the manner in which the well was plugged, indicating where the mud fluid was placed and the method or methods used in introducing it into the hole. If cement or other plugs were used, state the character of same and depth placed, from feet to feet for each plug set.

Filled hole with heavy mud to 285'. Set plug at 285'. Displaced through drill pipe 15 sks. cement at 285'. Filled hole with heavy mud to 30'. set plug at 30'. Filled hole with cement to surface.

(If additional description is necessary, use BACK of this sheet)

Correspondence regarding this well should be addressed to PETROLEUM, INC. Address 100 Derby Building Wichita 2, Kansas

STATE OF KANSAS COUNTY OF SEDGWICK Eric H. Jager (employee of owner)


being first duly sworn on oath, says: That I have knowledge of the facts, statements, and matters herein contained and the log of the above-described well as filed and that the same are true and correct. So help me God.

(Signature) Eric H. Jager Exec. Vice-president 100 Derby Building Wichita 2, Kansas (Address)

SUBSCRIBED AND SWORN to before me this 28th day of March 19 50

My commission expires October 27, 1952.

Notary Public signature

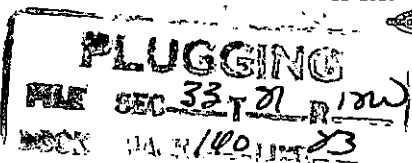

WELL LOG HARRIS NO. 1

Petroleum, Inc., Lease Owner

Section 33, Twp. 21S, Rge. 12W

Drillers, Inc., Contractor

Location: SW NE NW

Rotary Total Depth: 3654'

County: Stafford, Kansas

Commenced: February 17, 1950

Production: Dry Hole

Completed: February 27, 1950

Elevation: 1862 D.F.

Casing: 298.06' of 8 5/8"

Figures below indicate bottom of formation:

40	Clay & Sand	3620	Shale
160	Gravel & Sand	3654	Conglomerate
200	Shale & Sand		
225	Shale & Shells	3654	R.T.D.
655	Red Bed		
690	Anhydrite		
855	Shale		<u>Tops</u>
1475	Shale & Shells	655	Anhydrite
1545	Shale & Lime	3149	Heebner
1910	Shale & Shells	3168	Toronto
1945	Lime	3285	Brown Lime
2090	Lime & Shale	3302	Lansing
2120	Shale & Shells	3509	Base K.C.
2625	Shale	3546	P.B.C.
2780	Shale & Lime		
2920	Shale & Shells		
3025	Lime		
3225	Lime & Shale		
3285	Shale		
3308	Lime		
3526	Shale		
3557	Viola (chert)		

I hereby certify that this is a true and correct log of the above mentioned well.

PETROLEUM, INC.

W.W. Fisher

W. W. Fisher

STATE OF KANSAS

SS.

SEDGWICK COUNTY

Plat 517
FILE SEC 33 T. 21 R. 12W
BOOK PAGE 140 LINE 23

Subscribed to and sworn to before me, a Notary Public in said County and State, this 3rd day of March, 1950.

Marjorie Bradshaw
Notary Public

My Commission Expires: October 27, 1952.