


WELL PLUGGING RECORD

Give All Information Completely
Make Required Affidavit
Mail or Deliver Report to:
Conservation Division
State Corporation Commission
211 No. Broadway
Wichita, Kansas

NORTH

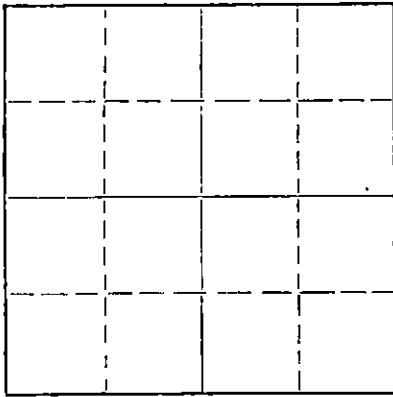

Locate well correctly on above
Section Plat

Stafford County, Sec. 33 Twp. 21 Rge. 12 (E) (W)
Location as "NE/CNWxSWx" or footage from lines SW/NE/NE
Lease Owner Great Bend Pipe & Supply Co.
Lease Name Sittner Well No. #3
Office Address West 10th-Box 111, Great Bend, Kansas
Character of Well (completed as Oil, Gas or Dry Hole) _____
Date well completed _____ 19____
Application for plugging filed Yes 19____
Application for plugging approved Yes 19____
Plugging commenced 11-22 19 57
Plugging completed 11-27 19 57
Reason for abandonment of well or producing formation _____

If a producing well is abandoned, date of last production _____ 19____
Was permission obtained from the Conservation Division or its agents before plugging was commenced? Yes

Name of Conservation Agent who supervised plugging of this well Mr. R.M. Brundedge
Producing formation _____ Depth to top _____ Bottom _____ Total Depth of Well 3605' Feet
Show depth and thickness of all water, oil and gas formations.

OIL, GAS OR WATER RECORDS

CASING RECORD

FORMATION	CONTENT	FROM	TO	SIZE	PUT IN	PULLED OUT
				5 1/2"		2,894'

Describe in detail the manner in which the well was plugged, indicating where the mud fluid was placed and the method or methods used in introducing it into the hole. If cement or other plugs were used, state the character of same and depth placed, from _____ feet to _____ feet for each plug set.

Measured into T.D. 3605'.
Plugging started 11-22-57. Finished 11-27-57.
Plugged off bottom with sand to 3380' and dumped 5 sacks cement.
Shot 5 1/2" casing at 2894'. Pulled pipe out of hole and mudded to 270'.
Set rock bridge and dumped 35 sacks cement. Filled hole with mud to 40'.
Set permanent rock bridge and mixed 10 sacks for cap on well. Well completed.

STATE CO.

DEC 5 1957

CONSERVATION DIVISION

Wichita, Kansas

12-5-1957

(If additional description is necessary, use BACK of this sheet)
Name of Plugging Contractor J.O. Forbes d/b/a Forbes Casing Pulling Co.
Address Box 221, Great Bend, Kansas

STATE OF Kansas, COUNTY OF Barton, ss.
J.O. Forbes (employee of owner) or (owner or operator) of the above-described

well, being first duly sworn on oath, says: That I have knowledge of the facts, statements, and matters herein contained and the log of the above-described well as filed and that the same are true and correct. So help me God.

(Signature)

J.O. Forbes
Box 221, Great Bend, Kansas
(Address)

SUBSCRIBED AND SWORN TO before me this 2nd day of December, 1957

Betty S. Edman
Notary Public.

My commission expires November 8, 1960.

