

STATE OF KANSAS
STATE CORPORATION COMMISSION

WELL PLUGGING RECORD

OR

FORMATION PLUGGING RECORD

Strike out upper line
when reporting plug-
ging off formations.

Give All Information Completely
Make Required Affidavit
Mail or Deliver Report to:
Conservation Division
State Corporation Commission
800 Bittling Building
Wichita, Kansas

STAFFORD County. Sec. 33 Twp. 21 Rge. 12 (E) (W)

Location as "NE 1/4 NW 1/4 SW 1/4" or footage from lines. NE-NE-NE

Lease Owner. ARTNELL CO

Lease Name. SITNER Well No. 1

Office Address. FLORENCE KANSAS -

Character of Well (completed as Oil, Gas or Dry Hole). OIL

Date well completed. AUG - 5 - 1937 19.

Application for plugging filed. FEB 5 19. 52

Application for plugging approved. " 19. 52


Plugging commenced. " 20 19. 52

Plugging completed. " 20 19. 52

Reason for abandonment of well or producing formation. OUT OF OIL

If a producing well is abandoned, date of last production. NOVEMBER - 19. 51

Was permission obtained from the Conservation Division or its agents before plugging was commenced? YES

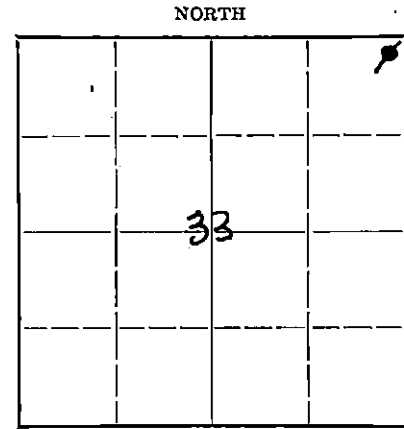

Locate well correctly on above
Section Plat

Name of Conservation Agent who supervised plugging of this well. RUEL DURKEE

Producing formation. SIMPSON Depth to top. 3610 Bottom. 3615 Total Depth of Well. 3615 Feet

Show depth and thickness of all water, oil and gas formations. 3604

OIL, GAS OR WATER RECORDS

CASING RECORD

Formation	Content	From	To	Size	Put In	Pulled Out
LANISING	OIL-GAS	3278		7"	3355'	3245'
SIMPSON	OIL	3604		5 1/2"	3595'	3376'
SURFACE	WATER	-		12 1/2"	320'	185'

Describe in detail the manner in which the well was plugged, indicating where the mud fluid was placed and the method or methods used in introducing it into the hold. If cement or other plugs were used, state the character of same and depth placed, from _____ feet to _____ feet for each plug set.

3603 - 3575 SAND
 3575 - 3540 5 SAY CEMENT
 3540 - 3350 MUDDED
 3350 - 3340 SAND BRIDGE
 3340 - 3310 5 SAY CEMENT
 3310 - 230 MUD
 230 - 220 ROCK BRIDGE
 220 - 195 20 SAY CEMENT
 195 - 20 MUD
 20 - 15 ROCK BRIDGE
 15 - TO CELLAR 10 SAY CEMENT

DRILLED BY TORY & FEASTER 1937 BOT FROM M. STEINBUCHEL
(NO LOG AVAILABLE) IN 1945

(If additional description is necessary, use BACK OF THIS CARD)

Correspondence regarding this well should be addressed to,

Address. BENJAMIN E. MINTURN
Artnell Company
FLORENCE, KANS.

STATE OF KANSAS, COUNTY OF Sedgewick, ss.

_____, (employee or owner) or (owner or operator) of the above-described well,
being first duly sworn on oath, says: That I have knowledge of the facts, statements, and matters herein contained and the log of the above-
described well as filed and that the same are true and correct. So help me God.

(Signature) Benjamin E. Minturn (Manager)
Florence, Kans
(Address)

SUBSCRIBED AND SWORN to before me this 1st day of March 19. 52

My Commission Expires Jan. 31, 1953 RECEIVED
Notary Public.

My commission expires. STATE OF KANSAS 22-237 7-47-10M


PLUGGING
FILE SEC 33 T 21 R 1 W
BOOK PUBLIC RECORDS 29
MAY 1 - 1952 3-1-52

TORREY AND FEASTER
 Sittner No. 1.

SEC. 33 T. 21 R. 12W.
 NE 1/4 NE

Total Depth. 3412.
 Comm. 6-30-37 Comp. 8-5-37
 Shot or Treated. 1000 gal acid.
 Contractor.
 Issued. 10-23-37

County Stafford.

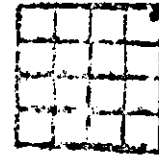

CASING.

13" 241' 7" 3350'

Elevation.

Production. Pot. 1408 B.

Figures Indicate Bottom of Formations.


sand	240
red bed	305
red bed and sand	331
red bed	578
red bed and shells	750
shale and shells	1250
shale and lime shells	1468
broken lime	1518
broken lime and shale	1888
lime hard	1913
broken lime	1923
lime hard	1967
lime and shale	2076
shale and shells	2097
lime and shale	2840
Topeka lime	2857
lime hard	2960
shale and shells	3003
lime	3065
Topeka lime	3078
lime	3114
red bed	3180
red rock	3208
red rock and shale blue	3233
shale blue	3262
lime	3270
shale blue	3278
K.C. lime	3328
cored	3338
K.C. lime drilled	3350
K.C. lime	3405
lime cored	3412
Total Depth.	

FILED 33: 21 12W
 BOOK PAGE 148 LINE 29

FEB 11 1952

WELL LOG BUREAU -- KANSAS GEOLOGICAL SOCIETY.
412 Union National Bank Bldg, Wichita, Kansas.TORREY AND FEASTER
Sittner No. 1.SEC. 33 T. 21 R. 12W.
NEC NETotal Depth. 3412.
Comm. 6-30-37 Comp. 8-5-37
Shot or Treated. 1000 gal acid.
Contractor.
Issued. 10-23-37

County Stafford.

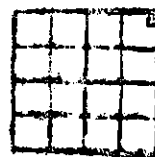

CASING.

13" 241' 7" 3350'

Elevation.

Production. Pot. 1408 B.

Figures Indicate Bottom of Formations.

sand	240
red bed	305
red bed and sand	331
red bed	578
red bed and shells	750
shale and shells	1250
shale and lime shells	1468
broken lime	1518
broken lime and shale	1888
lime hard	1913
broken lime	1923
lime hard	1967
lime and shale	2076
shale and shells	2097
lime and shale	2840
Topeka lime	2857
lime hard	2960
shale and shells	3003
lime	3065
Topeka lime	3078
lime	3114
red bed	3180
red rock	3208
red rock and shale blue	3233
shale blue	3262
lime	3270
shale blue	3278
K.C. lime	3328
cored	3338
K.C. lime drilled	3350
K.C. lime	3405
lime cored	3412
Total Depth.	

PLUGGING

FILE SEC. 33 T. 21 R. 12W.

PAGE 142 OF 29