


WELL PLUGGING RECORD

Give All Information Completely
Make Required Affidavit
Mail or Deliver Report to:
Conservation Division
State Corporation Commission
800 Bittling Building
Wichita, Kansas

C NE NW 1/4

Pawnee County, Sec. 6 Twp. 21S. Rge. 15 (E)X (W)
Location as "NE/CNW 1/4 SW 1/4" or footage from lines 4290' W. of EL. & 330' S. of NL
Lease Owner Gulf Oil Corporation
Lease Name M. N. Gross Well No. 1
Office Address Box 661 Tulsa, Oklahoma
Character of Well (completed as Oil, Gas or Dry Hole) Oil
Date well completed 8-21 1947
Application for plugging filed 3-18 1953
Application for plugging approved 3-20 1953
Plugging commenced 3-30 1953
Plugging completed 4-2 1953
Reason for abandonment of well or producing formation Not economical to operate

NORTH

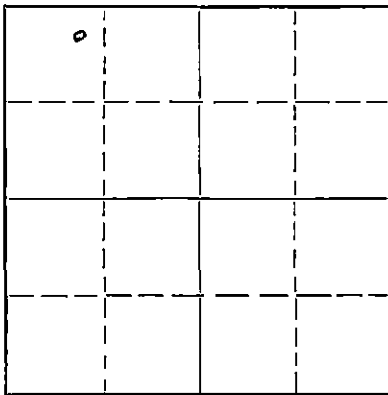

Locate well correctly on above
Section Plat

If a producing well is abandoned, date of last production 8-4 1952
Was permission obtained from the Conservation Division or its agents before plugging was commenced? Yes

Name of Conservation Agent who supervised plugging of this well M. A. Rives
Producing formation Arbuckle Depth to top 3762' Bottom PB 3806' Total Depth of Well PB 3806' Feet
Show depth and thickness of all water, oil and gas formations.

OIL, GAS OR WATER RECORDS

CASING RECORD

Formation	Content	From	To	Size	Put In	Pulled Out
				8-5/8"	989'	None
				5-1/2"	3860'	1613'

Describe in detail the manner in which the well was plugged, indicating where the mud fluid was placed and the method or methods used in introducing it into the hole. If cement or other plugs were used, state the character of same and depth placed, from _____ feet to _____ feet for each plug set.

PB with sand and gravel from 3806-3775'. Dumped 5 sacks cement 3775-3750'.
Mudded hole to 250'. Set rock bridge & dumped 20 sacks cement on bridge.
Filled with mud to 20' of surface and capped with 10 sacks.

(If additional description is necessary, use BACK of this sheet)

Name of Plugging Contractor G. E. Shull Casing Pulling Company
Address Great Bend, Kansas

STATE OF Kansas, COUNTY OF Rice, SS.
W. H. Duley (employee of owner or contractor) of the above-described well,
being first duly sworn on oath, says: That I have knowledge of the facts, statements, and matters herein contained and the log of the above-described well as filed and that the same are true and correct. So help me God.

(Signature) W. H. Duley

Box 544 Chase, Kansas (Address)

SUBSCRIBED AND SWORN to before me this 7th day of April, 1953

My commission expires April 14, 1956 Notary Public.

23-8390-s 6-51-20M

PLUGGING
FILE SEC 6 T 21 R 15 W
BOOK PAGE 27 LINE 22

STATE CORPORATION COMMISSION
APR 2 1953 4-8-53
CONSERVATION DIVISION
Wichita, Kansas

15.145.01283.0000

WELL NO. 12 LEASE M. N. Gross COMPANY Gulf Oil Corporation A.F.E. 3317
 DATE—DRILLING BEGAN 6-5-47 WELL COMPLETED 8-21-47 FIRST PRODUCTION 8-21-47
 SAND RECORD Arbuckle 3762' (Perf. 3801-06') TOTAL DEPTH 3806'
 P.B. from 3860'
 INITIAL PRODUCTION OIL: "F" 97 Barrels
 WATER: 3 Barrels

CASING RECORD

SIZE	WEIGHT	THD.	CLASS	MAKE	SET AT DEPTH	SACKS CEMENT	LB. CAL. CHLO.	PULLED	LEFT IN
8 5/8" 24	8R	A	LW	989'	485				989'
* 5 1/2" 14	8R	A	Smls.	3860'	150.				3860'

* Perforated 3760' with 4 holes.

S-6 T-21S R-15W

0		4290' WEL
		330' SNL
		Pawnee
		County
		Kansas

DISTANCE H: From top collar to rotary bushing on 5 1/2" is 4'6"

ELEVATION—1989'

PERFORATED: 3801-06' with 36 holes.
 twice 3805-15' each with 60 holes. (squeezed off)
 3807-09' with 12 holes. (squeezed off)
 3809-11' with 12 holes. (squeezed off)
 3814-24' with 30 holes. (squeezed off)

ACIDIZED: with 2000 gallons 6-26-47
 with 500 gallons 7-8-47
 with 500 gallons 7-31-47
 with 300 gallons 8-12-47
 with 250 gallons 8-16-47
 with 100 gallons 8-21-47

FORMATION RECORD:

FROM	TO	DESCRIPTION
0	70	Surface Sand and Clay
	95	Sand Rock
	145	Clay and Sand
	410	Shale and Sand
	982	Red bed and Shale
	991	Anhydrite
	1020	Anhydrite
	1170	Red Bed and Shale
	1980	Shale and Shells
	2030	Shale
	2075	Lime
	2200	Shale and Lime
	2390	Lime
	2440	Shale
	2595	Shale and Shells
	2785	Shale
	2830	Shale and Lime
	3230	Broken Lime
	3259	Shale
	3341	Lime
	3460	Broken Lime
	3496	Shale and Lime
	3644	Lime
	3750	Lime and Shale
	3860	Lime
		TOTAL DEPTH

RECEIVED
 PLUGGING
 FILE SEC 6 T 21 R 15 W
 BOOK PAGE 22 LINE 22