


WELL PLUGGING RECORD

Give All Information Completely
Make Required Affidavit
Mail or Deliver Report to:
Conservation Division
State Corporation Commission
211 No. Broadway
Wichita, Kansas

NORTH

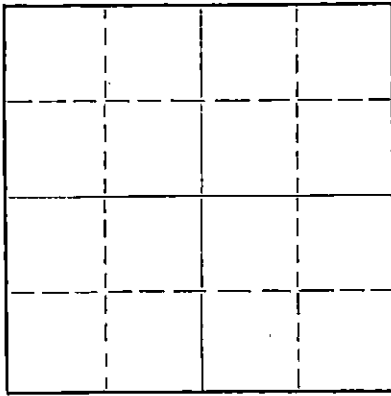

Locate well correctly on above
Section Plat

Pawnee County. Sec. 6 Twp. 21 Rge. 15 (E) (W)
Location as "NE/CNW&SW" or footage from lines SW NE NW
Lease Owner ~~XXXXXXXXXXXX~~ T.L. Nutt
Lease Name A.S. Gross Well No. 3
Office Address Box 407, Ellinwood, Ks
Character of Well (completed as Oil, Gas or Dry Hole) SWD
Date well completed January 7 19 48
Application for plugging filed January 2 19 58
Application for plugging approved January 2 19 58
Plugging commenced January 15 19 58
Plugging completed January 18 19 58
Reason for abandonment of well or producing formation _____

If a producing well is abandoned, date of last production _____ 19____
Was permission obtained from the Conservation Division or its agents before plugging was commenced? Yes

Name of Conservation Agent who supervised plugging of this well Frank Broadfoot
Producing formation _____ Depth to top _____ Bottom _____ Total Depth of Well 4415' Feet
Show depth and thickness of all water, oil and gas formations.

OIL, GAS OR WATER RECORDS

CASING RECORD

FORMATION	CONTENT	FROM	TO	SIZE	PUT IN	PULLED OUT
				5 1/2"	401.5'	3237'
				8 5/8"	99'	None

Describe in detail the manner in which the well was plugged, indicating where the mud fluid was placed and the method or methods used in introducing it into the hole. If cement or other plugs were used, state the character of same and depth placed, from _____ feet to _____ feet for each plug set.

4399' to 4030' Sand Bridge
4030' to 4005' 5 sks cement by dump bailer
4005' to 900' Mud shoveled in
900' to 890' Rock Bridge
890' to 875' 5 sacks cement
875' to 300' Mud shoveled in
300' to 285' Rock Bridge
285' to 180' 20 sacks cement
180' to 30' Mud shoveled in
30' to cellar Ran cement cap - 10 sacks

STATE CORPORATION COMMISSION

FEB 12 1958 2-12-1958

CONSERVATION DIVISION
Wichita, Kansas

(If additional description is necessary, use BACK of this sheet)

Name of Plugging Contractor Glenn & Smith Pine Pulling Co
Address Ellinwood, Kansas

STATE OF KANSAS, COUNTY OF BARTON, ss.
T.L. Nutt (employee of owner) or (owner or operator) of the above-described well, being first duly sworn on oath, says: That I have knowledge of the facts, statements, and matters herein contained and the log of the above-described well as filed and that the same are true and correct. So help me God.

(Signature) T.L. Nutt
Box 407 - Ellinwood
(Address)

SUBSCRIBED AND SWORN TO before me this 11 day of FEB., 1958

My commission expires Mar 21, 1959

Emory H. Ware
Notary Public.

PLUGGING
FILED SEC 6 T 21 R 15
BOOK PAGE 73 LINE 6

Well Log Bureau Kansas Geological Society

Company - Gulf Oil Corp
Farm - M.N. Gross #3

Sec 6 T. 21 R 15W
SW NE NW
County - Pawnee, Kansas

Total Depth 4415'
Comm. 12-19-47 Comp 1-7-48

Casing

8-5/8" 991' Cem w/435 sax
5-1/2" 4045' Cem w/100 sax

Sand	335
shale	400
red bed	700
shale	860
sand & shale	915
shale	965
red bed	978
anhydrite	992
shale	1500
shale & shells	1760
lime	2015
shale	2160
lime	2305
lime & shale	3135
lime	3405
lime & shale	3435
lime	3720
lime & shale	3780
conglomerate	3835
lime & chert	4005
lime	4415

Total Depth before completing
as SWDW was 3887'

Tops:

Lansing	3419
Base K.C.	3668
PBC	3706
Arbuckle	3887
Pre-Cambrian	4399

Top Cellar on 5 1/2"
is 8' below KB

Formation: Top Granite 4399'

RECEIVED
STATE CORPORATION COMMISSION

FEB 12 1958

CONSERVATION DIVISION
Wichita, Kansas

PLUGGING

FILE: SEC 6 T. 21 R. 15W
BOOK PAGE 73 LINE 6