

15-009-07029-00-00

STATE OF KANSAS
STATE CORPORATION COMMISSION

Form CP-4

Give All Information Completely
Make Required Affidavit
Mail or Deliver Report to:
Conservation Division
State Corporation Commission
211 No. Broadway
Wichita, Kansas

WELL PLUGGING RECORD

Barton County, Sec. 28 Twp. 16 Rge. 12 (E) 11W11

Location as "NE/CNW/SW" or footage from lines NW NW SW

Lease Owner H. C. Bennett

Lease Name Joe Finger Well No. 6

Office Address 1212 Union Nat'l Bldg., Wichita

Character of Well (completed as Oil, Gas or Dry Hole) oil

Date well completed 9-19 19 51

Application for plugging filed 12-11 19 63

Application for plugging approved 19


Plugging commenced 12-13 19 63

Plugging completed 12-20 19 63

Reason for abandonment of well or producing formation depleted

If a producing well is abandoned, date of last production 19

Was permission obtained from the Conservation Division or its agents before plugging was commenced? yes

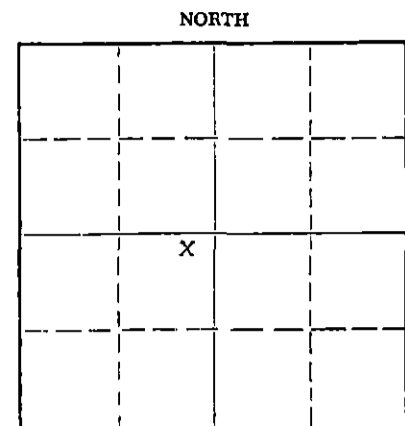

Locate well correctly on above Section Plat

Name of Conservation Agent who supervised plugging of this well Donald Eruan

Producing formation _____ Depth to top _____ Bottom _____ Total Depth of Well 3347 Feet

Show depth and thickness of all water, oil and gas formations.

OIL, GAS OR WATER RECORDS

CASING RECORD

FORMATION	CONTENT	FROM	TO	SIZE	PUT IN	PULLED OUT
				8 5/8	190	circulated
				5 1/2	3369	2681.40

Describe in detail the manner in which the well was plugged, indicating where the mud fluid was placed and the method or methods used in introducing it into the hole. If cement or other plugs were used, state the character of same and depth placed, from _____ feet to _____ feet for each plug set.

Set 10 foot rock bridge at 3090 feet and dumped 5 sacks cement.
Glove cementing co. pumped 10 sacks of jell and 90 sacks
cement down surface pipe.

RECEIVED
STATE CORPORATION COMMISSION

JAN 3 1964 1-3-64

CONSERVATION DIVISION
Wichita, Kansas

(If additional description is necessary, use BACK of this sheet)

Name of Plugging Contractor Flint Engineering & Construction Co.

Address Box 342, El Dorado, Kansas

STATE OF Kansas, COUNTY OF Butler, ss.

(employee of owner) or (owner or operator) of the above-described well, being first duly sworn on oath, says: That I have knowledge of the facts, statements, and matters herein contained and the log of the above-described well as filed and that the same are true and correct. So help me God.

(Signature) Mary Payne
El Dorado
(Address)

SUBSCRIBED AND SWORN to before me this 31st day of December, 19 63

My commission expires Sept 27, 1967

Ronald R. Harrison
Notary Public.

WELL LOG BUREAU--KANSAS GEOLOGICAL SOCIETY
508 East Murdock, Wichita, Kansas


COPY

Company: DERBY DRILLING COMPANY ET AL
Farm: Finger No. 6

SEC. 28 T. 16 R. 12W
NW NW SW

Total Depth. 3378
Comm. 9-2-51 Comp. 9-19-51
Shot or Treated.
Contractor. Rocket Drlg. Co.
Issued. 1-9-54

County Barton KANSAS

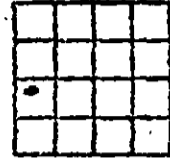

Elevation. 1915 DF
Production. 75 BOPD

CASING:

8 5/8" 190' cem. w/125 sx
5 1/2" 3369' cem. w/125 sx

Figures indicate Bottom of Formations.

soil, shale & shells	80
shale & shells	820
anhydrite	840
shale & shells	1535
salt & shale	1735
lime & shale	1836
sand	1860
lime	1965
lime & shale	2505
lime	2640
lime & shale	2745
lime	2885
lime & shale	2950
lime	3000
lime & shale	3123
lime	3370 RTD
lime	3378
Total Depth	

Tops:	
Anhydrite	820
Heebner	3012
Brown Lime	3099
Lansing-Kansas City	3117
Base-Kansas City	3357
Arbuckle	3367

Oil shows at 3118-21'
3127-32', 3145-49',
3161-66', 3183-91',
3248-56', 3280-86',
3314-21', 3367-70'

DST: #1 3103-52' open 20 mins.
gas to the surface in 19 mins.
rec. 420' fluid (30' SOGCM,
90' HOGCM, and 300' muddy oil,
BHP 980#.

Ran Schlumberger Laterolog Survey
(previously released)
Cable Tool completion:
COTB 3370, 200' oil in 1 hr.
tested 5 1/2 BOPH; drld. deeper
6' from 3370 to 3376, filled
up 200' oil, no wtr, drld.
deeper 3376 to 3378 filled up
2175' oil, no wtr, put on
production (no acid) completed
for 75 bopd (un-prorated)

RECEIVED
STATE CORPORATION COMMISSION

JAN 3 1964

CONSERVATION DIVISION
Wichita, Kansas

3117
1915

1202

3096
1894

1202

3378
1915

1463