

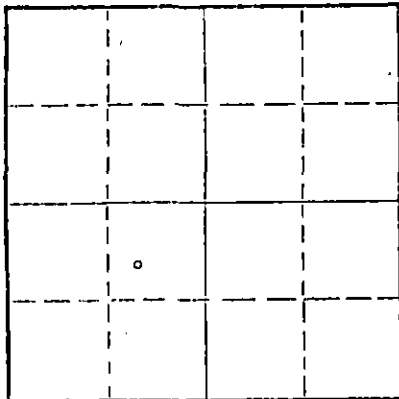
STATE OF KANSAS
STATE CORPORATION COMMISSION

Form CP-4

Give All Information Completely
Make Required Affidavit
Mail or Deliver Report to:
Conservation Division
State Corporation Commission
212 No. Market
Wichita, Kansas

WELL PLUGGING RECORD

NORTH

Locate well correctly on above
Section Plat

Barton County. Sec. 28 Twp. 16 Rge. 12 (E) (W)
Location as "NE/CNW/SW" or footage from lines SW NE SW
Lease Owner Duke Drilling Company, Inc.
Lease Name FTINGER Well No. 1
Office Address Box 823 - Great Bend, Kansas
Character of Well (completed as Oil, Gas or Dry Hole) Dry Hole
Date well completed April 19 19 68
Application for plugging filed " 19 68
Application for plugging approved " 19 68
Plugging commenced " 19 68
Plugging completed " 19 68
Reason for abandonment of well or producing formation _____

If a producing well is abandoned, date of last production _____ 19 ____
Was permission obtained from the Conservation Division or its agents before plugging was commenced? yes

Name of Conservation Agent who supervised plugging of this well Don Truan
Producing formation _____ Depth to top _____ Bottom _____ Total Depth of Well 3385 Feet
Show depth and thickness of all water, oil and gas formations.

OIL, GAS OR WATER RECORDS

CASING RECORD

FORMATION	CONTENT	FROM	TO	SIZE	PUT IN	PULLED OUT

Describe in detail the manner in which the well was plugged, indicating where the mud fluid was placed and the method or methods used in introducing it into the hole. If cement or other plugs were used, state the character of same and depth placed, from _____ feet to _____ feet for each plug set.

Filled hole with heavy mud to 350' - set plug 1/4 sack hulls, 25 sacks cement through drill pipe.

Filled hole to 40' - set plug 1/4 sack hulls, made good bridge, 10 sacks cement.

Plugged rat hole 2 sacks cement.

RECEIVED
STATE CORPORATION COMMISSION

APR 23 1968

CONSERVATION DIVISION
Wichita, Kansas

(If additional description is necessary, use BACK of this sheet)

Name of Plugging Contractor _____

Address _____

STATE OF KANSAS, COUNTY OF BARTON, ss.

L. O. Chubb (employee of owner) or (owner operator) of the above-described well, being first duly sworn on oath, says: That I have knowledge of the facts, statements, and matters herein contained and the log of the above-described well as filed and that the same are true and correct. So help me God.

(Signature) _____

Box 823 - Great Bend, Kansas
(Address)SUBSCRIBED AND SWORN TO before me this 22 day of April, 19 68

My commission expires _____

4-11-70Dorothy M. Hague
Notary Public.

15-009-20216-00-00

W E L L L O G

DATE COMMENCED: April 11, 1968
DATE COMPLETED: April 20, 1968

Duke Drilling Company, Inc.
FINGER #1
SW NE SW Section 28-16-12w
Barton County, Kansas

0 - 45' Clay Post Rock
45 - 60' Post Rock Shale
60 - 400' Shale
400 - 515' Shale & Sand
515 - 804' Red Bed
804 - 830' Anhydrite
830 - 1520' Shale & Shells
1520 - 1992' Lime & Shale
1992 - 2704' Shale Lime Shells
2704 - 3002' Lime
3002 - 3006' Shale
3006 - 3031' Lime Shale
3031 - 3088' Shale
3088 - 3107' Brown Lime Shale
3107 - 3343' Lime
3343 - 3385' Conglomerate

ELEVATION: 1902 K.B.

FORMATION DATA

Anhydrite 804
Heebner 3002
Brown Lime 3088
Lansing 3107
Conglomerate 3343
RTD 3385

SURFACE CASING: Set 8-5/8"
at 536' with 250 sacks
cement.

A F F I D A V I T

STATE OF KANSAS,
COUNTY OF BARTON)

L. O. Chubb, of lawful age, does swear and state that the facts
and statements herein contained are true and correct to the best of
his knowledge.

Subscribed and sworn to before me this 22 day of April, 1968

My Comm. Expires:
4-11-70

Harold M. Hague
Notary Public

RECEIVED
STATE CORPORATION COMMISSION
APR 23 1968
CONSERVATION DIVISION
Wichita, Kansas