

CARD MUST BE TYPED

State of Kansas
NOTICE OF INTENTION TO DRILL
(see rules on reverse side)

CARD MUST BE SIGNED
CORRECTED LOCATION

Starting Date: 10 19 1984
month day year

API Number 15- 15-191-21,757.0000 *5-285*

OPERATOR: License # 5643

SW SW NW Sec . 5 . Twp . 33 S, Rge . 1 . East
 West
(Location)

Name JENKINS & BROYLES PROD. CO.

Address RR #2 Box 20

City/State/Zip Arkansas City, Kans. 67005

Contact Person Ed Broyles

Phone (316) 442-6334

* 2970 Ft North from Southeast Corner of Section

* 4950 Ft West from Southeast Corner of Section

(Note: Locate well on Section Plat on reverse side)

CONTRACTOR: License # 9804

Name B & W Drilling Company

City/State Arkansas City, Kans. 67005

Nearest lease or unit boundary line 330 feet.

County SUMNER

Lease Name ANCELL Well# 4

Domestic well within 330 feet: yes no

Municipal well within one mile: yes no

Well Drilled For: Well Class: Type Equipment:

- | | | | |
|---|-------------------------------|---|--|
| <input checked="" type="checkbox"/> Oil | <input type="checkbox"/> Swd | <input type="checkbox"/> Infield | <input checked="" type="checkbox"/> Mud Rotary |
| <input type="checkbox"/> Gas | <input type="checkbox"/> Inj | <input checked="" type="checkbox"/> Pool Ext. | <input type="checkbox"/> Air Rotary |
| <input type="checkbox"/> OWWO | <input type="checkbox"/> Expl | <input type="checkbox"/> Wildcat | <input type="checkbox"/> Cable |

If OWWO: old well info as follows:

Operator

Well Name

Comp Date Old Total Depth

Projected Total Depth 4100 feet

Projected Formation at TD

Expected Producing Formations

Depth to Bottom of fresh water 60 feet

Lowest usable water formation Wellington

Depth to Bottom of usable water 250 feet

Surface pipe by Alternate: 1 2

Surface pipe to be set 250 feet

Conductor pipe if any required None feet

Ground surface elevation feet MSL

This Authorization Expires *4-19-85*

Approved By *10-19-84*

I certify that we will comply with K.S.A. 55-101, et seq., plus eventually plugging hole to K.C.C. specifications.

* Was 3300' FSL

* Was 4620 FEL

Date 10-19-84 Signature of Operator or Agent *Frank Beard*


Title Agent

RECEIVED
STATE CORPORATION COMMISSION

Must be filed with the K.C.C. five (5) days prior to commencing well
This card void if drilling not started within six (6) months of date received by K.C.C.

MAY 2 1985

CONSERVATION DIVISION
A Regular Section of Land
1 Mile = 5,280 Ft.

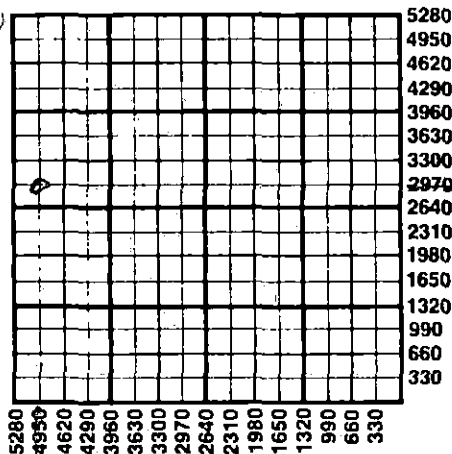

Important procedures to follow :

1. Notify District office before setting surface casing.
2. Set surface casing by circulating cement to the top.
3. File completion forms ACO-1 with K.C.C. within 90 days of well completion, following instructions on ACO-1, side 1, and including copies of wireline logs.
4. Notify District office 48 hours prior to old well workover or re-entry.
5. Prior to plugging, prepare a plugging plan, then obtain agreement from the appropriate district office for an approved plugging plan.
6. Submit plugging report (CP-4) to K.C.C. after plugging is completed.
7. Obtain an approved injection docket number before disposing of salt water.
8. Notify K.C.C. within 10 days when injection commences or terminates.
9. If an alternate 2 completion, cement in the production pipe from below any usable water to surface within 120 days of spud date.

State Corporation Commission of Kansas
Conservation Division
200 Colorado Derby Building
Wichita, Kansas 67202
(316) 263-3238