

CARD MUST BE TYPED

State of Kansas
NOTICE OF INTENTION TO DRILL
(see rules on reverse side)

CARD MUST BE SIGNED

Starting Date: 9-21-84
month day year

API Number 15- 009-23,721-00-00

OPERATOR: License # 8399
Name Great Bend Oil Producers
Address P.O. Box 1054
City/State/Zip Great Bend, KS 67530
Contact Person Garey Pennington
Phone (316) 792-3923

SE NW NE
(location) 27.. Twp16.. S, Rge 12..
4290 Ft North from Southeast Corner of Section
1650 Ft West from Southeast Corner of Section
(Note: Locate well on Section Plat on reverse side)

CONTRACTOR: License # 6394
Name Mohawk Drilling, Inc.
City/State Great Bend, KS 67530

Nearest lease or unit boundary line 330 feet.
County Barton
Lease Name Dorothy Reif Well# 1

Well Drilled For: Well Class: Type Equipment:
 Oil Swd Infield Mud Rotary
 Gas Inf Pool Ext. Air Rotary
 OWWO Expl Wildcat Cable

Domestic well within 330 feet: yes no
Municipal well within one mile: yes no

If OWWO: old well info as follows:
Operator
Well Name
Comp Date Old Total Depth
Projected Total Depth 3400 feet
Projected Formation at TD Arbuckle
Expected Producing Formations Arbuckle

Depth to Bottom of fresh water 150 185 mHC feet
Lowest usable water formation Dakota
Depth to Bottom of usable water 480 380 mHC feet
Surface pipe by Alternate: 1 2
Surface pipe to be set 250 380 feet
Conductor pipe if any required N/A feet
Ground surface elevation 1916 feet MSL
This Authorization Expires 3-20-85
Approved By 9-20-84 [Signature]


I certify that we will comply with K.S.A. 55-101, et seq., plus eventually plugging hole to K.C.C. specifications.

Date 9-19-84 Signature of Operator or Agent [Signature] Title operator
mHC/KOHE 9/20/84 Form C-1 4/84

Must be filed with the K.C.C. five (5) days prior to commencing well
This card void if drilling not started within six (6) months of date received by K.C.C.

Important procedures to follow :

A Regular Section of Land
1 Mile = 5,280 Ft.

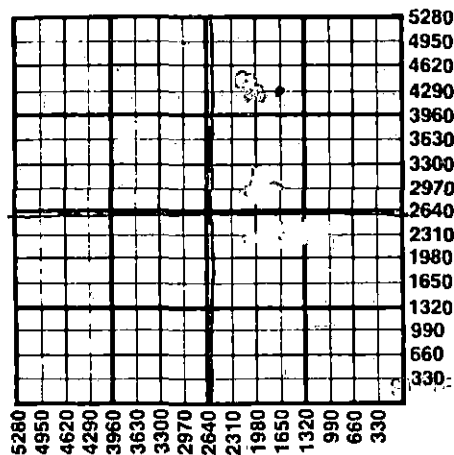

1. Notify District office before setting surface casing.
 2. Set surface casing by circulating cement to the top.
 3. File completion forms ACO-1 with K.C.C. within 90 days of well completion, following instructions on ACO-1, side 1, and including copies of wireline logs.
 4. Notify District office 48 hours prior to old well workover or re-entry.
 5. Prior to plugging, prepare a plugging plan, then obtain agreement from the appropriate district office for an approved plugging plan.
 6. Submit plugging report (CP-4) to K.C.C. after plugging is completed.
 7. Obtain an approved injection docket number before disposing of salt water.
 8. Notify K.C.C. within 10 days when injection commences or terminates.
- RECEIVED
If an alternate 2 completion, cement in the production pipe from below any usable water to surface within 120 days of spud date.

SEP 20 1984
9-20-84
SUNDAY
WICHITA

State Corporation Commission of Kansas
Conservation Division
200 Colorado Derby Building
Wichita, Kansas 67202
(316) 263-3238