


WELL PLUGGING RECORD

Give All Information Completely
Make Required Affidavit
Mail or Deliver Report to:
Conservation Division
State Corporation Commission
211 No. Broadway
Wichita, Kansas

Stafford County, Sec. 28 Twp. 21 Rge. 14 (E) (W)

Location as "NE/CNW/SW" or footage from lines NE SW SW
Lease Owner Hilton Drilling Company, Inc.
Lease Name Ratzlaff Well No. 2
Office Address 925 Patton Road, Great Bend, Kansas
Character of Well (completed as Oil, Gas or Dry Hole) dry hole
Date well completed August 25, 1957
Application for plugging filed August 27, 1957
Application for plugging approved August 26, 1957
Plugging commenced August 25, 1957
Plugging completed August 25, 1957
Reason for abandonment of well or producing formation dry

NORTH

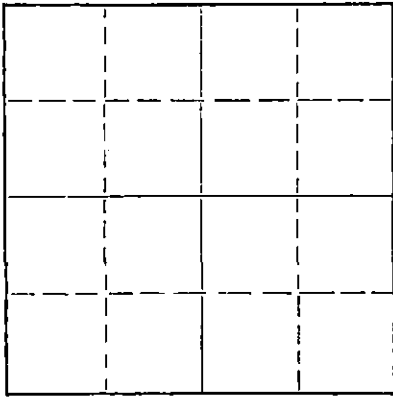

Locate well correctly on above
Section Flat

If a producing well is abandoned, date of last production _____ 19____
Was permission obtained from the Conservation Division or its agents before plugging was commenced? yes

Name of Conservation Agent who supervised plugging of this well R. M. Brundege
Producing formation _____ Depth to top _____ Bottom _____ Total Depth of Well 3825 Feet
Show depth and thickness of all water, oil and gas formations.

OIL, GAS OR WATER RECORDS

CASING RECORD

FORMATION	CONTENT	FROM	TO	SIZE	PUT IN	PULLED OUT
				8-5/8"	270'	None

Describe in detail the manner in which the well was plugged, indicating where the mud fluid was placed and the method or methods used in introducing it into the hole. If cement or other plugs were used, state the character of same and depth placed, from _____ feet to _____ feet for each plug set.

Filled hole with drilling mud to 240', set plug at 240' with sacks cement and 1/3 sacks hulls, filled with mud to 25' set plug at 25' with 5 sacks cement and 1/3 sacks hulls.

Name of Plugging Contractor Hilton Drilling Company, Inc. (If additional description is necessary, use BACK of this sheet)
Address Great Bend, Kansas

STATE OF Kansas, COUNTY OF Barton, ss.
Jack L. Craft, Assistant Secretary (employee of owner) or (owner or operator) of the above-described well, being first duly sworn on oath, says: That I have knowledge of the facts, statements, and matters herein contained and the log of the above-described well as filed and that the same are true and correct. So help me God.

(Signature) Jack L. Craft
Great Bend, Kansas
(Address)

SUBSCRIBED AND SWORN to before me this 27th day of August, 1957
Mildred Hobbie

My commission expires _____

PLUGGING
FILE SEC 20 T. 21 R. 14W
BOOK PAGE 39 LINE 43

Notary Public.
MILDRED HOBBIIE
MY COMMISSION EXPIRES MARCH 6, 1958
AUG 28 1957
8-28-1957
CONSERVATION DIVISION
Wichita, Kansas

DRILLER'S LOG

COMPANY: Hilton Drilling Company, Inc. LOCATION: NE SW SW
 Section 28-21S-14W
 CONTRACTOR: Hilton Drilling Company, Inc. Stafford County, Kansas
 FARM NAME: Ratzlaff No. 2 ELEVATION: 1943 D. F.
 COMMENCED: August 14, 1957 Casing Used: 8-5/8" set at 270' w/200 sxs.
 COMPLETED: August 26, 1957

Sand	90
Sand and Shale	271
Shale	325
Sand	390
Red Bed	865
Anhydrite	895
Red Bed, Shale & Shells	1405
Shale and Salt	1600
Shale and Lime	1705
Lime	1835
Shale and Lime	1990
Lime	2080
Shale and Lime	2970
Lime	3336
Shale and Lime	3355
Brk Lime and Shale	3455
Lime	3710
Lime and Conglomerate	3765
Lime and Chert	3825
Total Depth	3825

STATE OF KANSAS)
) SS.
 COUNTY OF BARTON)

I, the undersigned, being duly sworn on oath, state that the above statement and log are true and a correct record and log of the well drilled at the location above-described.

HILTON DRILLING COMPANY, INC.

Jack L. Cross

Subscribed and sworn to before me this 27th day of August, 1957.

RECEIVED
 STATE DEPARTMENT OF COMMISSION

Mildred Hobbie
 Notary Public

PLUGGING AUG 28 1957
 FILE SEC 20 T 21 R 14W DIVISION DIVISION
 BOOK PAGE 39 LINE 43
 Kansas, Kansas

MILDRED HOBBIIE
 MY COMMISSION EXPIRES MARCH 6, 1958