

STATE OF KANSAS  
STATE CORPORATION COMMISSION

Give All Information Completely  
Make Required Affidavit  
Mail or Deliver Report to:  
Conservation Division  
State Corporation Commission  
211 No. Broadway  
Wichita, Kansas

WELL PLUGGING RECORD

STAFFORD County. Sec. 28 Twp. 21S Rge. 14W ## (W)

Location as "NE/CNW/SW" or footage from lines C-W/2-SW-SW  
Lease Owner PETROLEUM, INC.

Lease Name RATZLAFF "C" Well No. 1

Office Address ROUTE 2, GREAT BEND, KANSAS

Character of Well (completed as Oil, Gas or Dry Hole) DRY HOLE

Date well completed MARCH 26, 1962

Application for plugging filed APRIL 12, 1962

Application for plugging approved APRIL 14, 1962


Plugging commenced APRIL 16, 1962

Plugging completed APRIL 21, 1962

Reason for abandonment of well or producing formation NO PRODUCIBLE ZONES

If a producing well is abandoned, date of last production ----- 19

Was permission obtained from the Conservation Division or its agents before plugging was commenced? YES

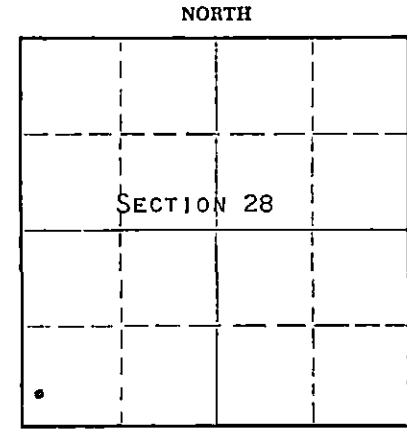

Locate well correctly on above Section Plat

Name of Conservation Agent who supervised plugging of this well FRED W. HAMPEL PRETTY PRAIRIE, KANSAS

Producing formation --- Depth to top --- Bottom --- Total Depth of Well 3814 Feet

Show depth and thickness of all water, oil and gas formations.

OIL, GAS OR WATER RECORDS

CASING RECORD

FORMATION	CONTENT	FROM	TO	SIZE	PUT IN	PULLED OUT
SIMPSON	WATER & LITTLE	3764'	3766'	8-5/8"	278'	NONE
	OIL	3771'	3772'	4-1/2"	3811'	834'

Describe in detail the manner in which the well was plugged, indicating where the mud fluid was placed and the method or methods used in introducing it into the hole. If cement or other plugs were used, state the character of same and depth placed, from \_\_\_\_\_ feet to \_\_\_\_\_ feet for each plug set.

PLUGGED BACK TO 3768'

COULD NOT RUN TOOLS PAST 940' DUE TO VERY HEAVY MUD AND SHALE. PIPE WAS APPARENTLY PARTED OR COLLAPSED BELOW THAT POINT. SHOT OFF AT 834' AND PULLED CASING. PUMPED 30 SACKS HEAVY JELL FROM 940' TO APPROXIMATELY 300', FOLLOWED BY 100 SACKS CEMENT TO BASE OF WELL CELLAR, PUMPED BY GLOBE CEMENTERS.

NOTE: WELL WAS WASHED DOWN. ORIGINALLY DRILLED BY HILTON DRILLING COMPANY TO A T.D. OF 3816' 8-5/8" 24# CASING SET BY HILTON DRILLING COMPANY AT 278'. WAS DRY & ABANDONED 3-1-57. WELL LOG WAS PREVIOUSLY FILED BY HILTON DRILLING COMPANY.

RECEIVED  
STATE CORPORATION COMMISSION

5-8-62 MAY 8 1962

(If additional description is necessary, use BACK of this sheet)

Name of Plugging Contractor SOUTHWEST CASING PULLING  
Address BOX 364, GREAT BEND, KANSAS

CONSERVATION DIVISION  
Wichita, Kansas

STATE OF KANSAS, COUNTY OF BARTON, ss.  
DON SEARLE (employee of owner) or (owner) of the above-described well, being first duly sworn on oath, says: That I have knowledge of the facts, statements, and matters herein contained and the log of the above-described well as filed and that the same are true and correct. So help me God.  
(Signature) Don Searle  
ROUTE 2, GREAT BEND, KANSAS  
(Address)

SUBSCRIBED AND SWORN TO before me this 4TH day of MAY, 1962

My commission expires APRIL 14, 1963

Notary Public

