


STATE OF KANSAS  
STATE CORPORATION COMMISSION

WELL PLUGGING RECORD

Give All Information Completely  
Make Required Affidavit  
Mail or Deliver Report to:  
Conservation Division  
State Corporation Commission  
800 Bittling Building  
Wichita, Kansas

NORTH

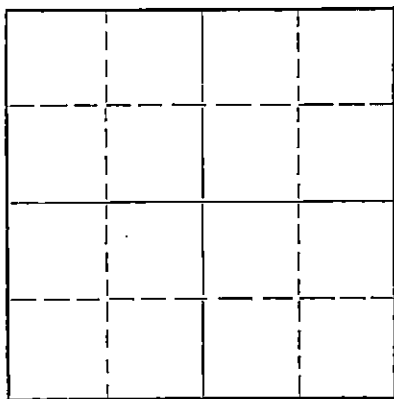

Locate well correctly on above  
Section Plat

Stafford County. Sec. 28 Twp. 21 Rge. 14 (E) (W)  
Location as "NE/CNW/SW" or footage from lines C W/2 SW SW  
Lease Owner Hilton Drilling Company, Inc.  
Lease Name Ratzlaff Well No. 1  
Office Address 925 Patton Road, Great Bend, Kansas  
Character of Well (completed as Oil, Gas or Dry Hole) Dry Hole  
Date well completed February 21, 19 57  
Application for plugging filed February 21, 19 57  
Application for plugging approved February 21, 19 57  
Plugging commenced February 21, 19 57  
Plugging completed February 21, 19 57  
Reason for abandonment of well or producing formation Dry Hole

If a producing well is abandoned, date of last production \_\_\_\_\_ 19\_\_\_\_  
Was permission obtained from the Conservation Division or its agents before plugging was commenced? Yes

Name of Conservation Agent who supervised plugging of this well R. B. Brundege  
Producing formation \_\_\_\_\_ Depth to top \_\_\_\_\_ Bottom \_\_\_\_\_ Total Depth of Well 3816 Feet  
Show depth and thickness of all water, oil and gas formations.

OIL, GAS OR WATER RECORDS

CASING RECORD

FORMATION	CONTENT	FROM	TO	SIZE	PUT IN	PULLED OUT
				8-5/8"	278'	None

Describe in detail the manner in which the well was plugged, indicating where the mud fluid was placed and the method or methods used in introducing it into the hole. If cement or other plugs were used, state the character of same and depth placed, from \_\_\_\_\_ feet to \_\_\_\_\_ feet for each plug set.

Filled hole with heavy mud, pushed 1/3 sack of hulls and plug to 240' and cemented with 20 sacks.  
Filled hole within 20' of top with heavy mud, set 1/3 sacks hulls and mixed with 5 sacks of cement.

(If additional description is necessary, use BACK of this sheet)

Name of Plugging Contractor Hilton Drilling Company, Inc.  
Address Great Bend, Kansas

STATE OF KANSAS, COUNTY OF BARTON, ss.  
Henry Peacock, Secretary (employee of owner) or (owner or operator) of the above-described well, being first duly sworn on oath, says: That I have knowledge of the facts, statements, and matters herein contained and the log of the above-described well as filed and that the same are true and correct. So help me God.

(Signature) Henry Peacock  
Great Bend, Kansas  
(Address)

SUBSCRIBED AND SWORN TO before me this 22nd day of February, 19 57

Mildred Hobbs

Notary Public.

My commission expires \_\_\_\_\_

24-7366-S 3-53-20M

PLUGGING  
FILE SEC. 28 T. 21 R. 14w  
BOOK PAGE 142 LINE 42

RECEIVED  
STATE CORPORATION COMMISSION  
2-23-1957  
FEB 23 1957  
CONSERVATION DIVISION  
WICHITA, KANSAS

## DRILLER'S LOG

COMPANY: Hilton Drilling Company, Inc.  
 CONTRACTOR: Hilton Drilling Company, Inc.  
 FARM NAME: Ratzlaff No. 1  
 COMMENCED: February 7, 1957  
 COMPLETED: February 21, 1957

LOCATION: C W/2 SW SW  
 Sec. 28-21S-14W  
 Stafford County, Kans.  
 ELEVATION: 1943 D.F.

Casing Used: 8-5/8" set @ 278' w/200 sxs.

Clay, Sand and Shale	278
Shale, and Sand	600
Red Bed and Sand	864
Anhydrite	890
Shale and Shells	1455
Shale and Lime	1700
Lime	2125
Shale and Lime	2735
Lime	2835
Shale and Lime	2985
Lime	3297
Shale and Lime	3381
Lime	3750
Chert, Lime and Shale	3791
Shale and Lime	3816
Total Depth	3816

STATE OF KANSAS )  
 ) SS.  
 COUNTY OF BARTON ))

I, the undersigned, being duly sworn on oath, state that the above statement and log are true and a correct record and log of the well drilled at the location above-described.

PLUGGING	
FILE SEC. 28 T. 21 R. 14w	
BOOK PAGE 142 LINE 42	

HILTON DRILLING COMPANY, INC.

*Henry Peacock*

Subscribed and sworn to before me this 22nd day of February, 1957

*Mildred Hobbie*  
 Notary Public

MILDRED HOBBIIE  
 MY COMMISSION EXPIRES MARCH 6, 1958

RECEIVED  
 STATE CORPORATION DEPARTMENT  
 FEB 23 1957  
 CONSERVATION DIVISION  
 Wichita, Kansas