


STATE OF KANSAS
STATE CORPORATION COMMISSION

WELL PLUGGING RECORD

Give All Information Completely
Make Required Affidavit
Mail or Deliver Report to
Conservation Division
State Corporation Comm.
245 North Water
Wichita, KS 67202

Stafford County. Sec. 28 Twp. 21 Rge. 14W E/W
Location as "NE/CNW $\frac{1}{2}$ SW $\frac{1}{4}$ " or footage from lines
NE NW SE
Lease Owner Harvey Gough
Lease Name Keenan Well No. 1
Office Address 411 Farmers And Bankers Building Wichita, Ks.
Character of Well (Completed as Oil, Gas or Dry Hole)
Dry Hole
Date Well completed 9-1-79 19
Application for plugging filed 9-1-79 19
Application for plugging approved 9-1-79 19
Plugging commenced 9-2-79 19
Plugging completed 9-2-79 19
Reason for abandonment of well or producing formation

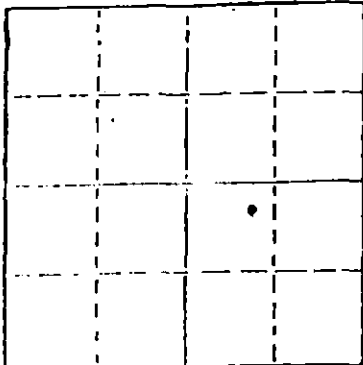

Locate well correctly on above Section Plat

If a producing well is abandoned, date of last production 19

Was permission obtained from the Conservation Division or its agents before plugging was commenced? Yes

Name of Conservation Agent who supervised plugging of this well Wm T. Owen
Producing formation Depth to top Bottom Total Depth of Well 3830
Show depth and thickness of all water, oil and gas formations.

OIL, GAS OR WATER RECORDS

CASING RECORD

FORMATION	CONTENT	FROM	TO	SIZE	PUT IN	PULLED OUT

Describe in detail the manner in which the well was plugged, indicating where the mud fluid was placed and the method or methods used in introducing it into the hold. If cement or other plugs were used, state the character of same and depth placed, from feet to feet for each plug set.

Mud To 540' 40 Sacks 50-50 Posmix
Mud To 240' 40 Sacks 50-50 Posmix
Mud To 40' 12 Sacks 50-50 Posmix
3 Sacks In Rat Hole

STATE RECEIVED
CORPORATION COMMISSION
SEP 17 1979
CONSERVATION DIVISION
WICHITA, KANSAS

(If additional description is necessary, use BACK of this report.)
Name of Plugging Contractor Merckle Drilling Co.

STATE OF Kansas COUNTY OF Barton, ss.
Clyde Merckle (employee of owner) or (owner or operator)
of the above-described well, being first duly sworn on oath, says: That I have knowledge of the facts, statements, and matters herein contained and the log of the above-described well as filed and that the same are true and correct. So help me God.

(Signature) Clyde Merckle

SUBSCRIBED AND SWORN TO before me this 14th day of September, 1979

(Address) Santa Fe
Notary Public.

My commission expires 3-28-80



Harvey Gough
 411 Farmers And Bankers Building
 Wichita, Kansas 67202

Keenan #1

NE NW SE Section 28 21 South 14 West

Stafford County


Driller's Log - Total 3830

0 - 235	Sand
235 - 305	Shale.
305 - 380	Sand
380 - 760	Shale and Red Bed
760 - 865	Shale and Sand
865 - 874	Anhydrite
874 - 1745	Shale and Lime Shells
1745 - 2425	Shale and Lime
2425 - 3000	Shale and Lime
3000 - 3475	Lime and Shale
3475 - 3830	Lime

RECEIVED
 STATE CORPORATION COMMISSION

SEP 17 1979

CONSERVATION DIVISION
 Wichita, Kansas

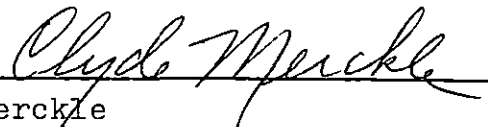
 Clyde Merckle