


WELL PLUGGING RECORD

Give All Information Completely  
Make Required Affidavit  
Mail or Deliver Report to:  
Conservation Division  
State Corporation Commission  
211 No. Broadway  
Wichita, Kansas

Stafford County, Sec. 27 Twp. 21 Rge. (E) 14 (W)

Location as "NE/CNW&SW" or footage from lines SE SE NW  
Lease Owner James Stewart  
Lease Name Devine Well No. 1  
Office Address 820 Union Center Bldg., Wichita, Kansas  
Character of Well (completed as Oil, Gas or Dry Hole) dry hole  
Date well completed 19  
Application for plugging filed May 18 19 64  
Application for plugging approved 19  
Plugging commenced May 19 19 64  
Plugging completed May 29 19 64  
Reason for abandonment of well or producing formation dry hole

NORTH

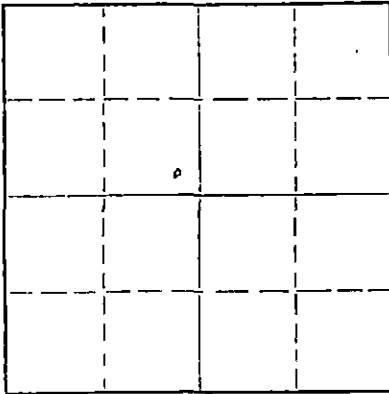

Locate well correctly on above  
Section Plat

If a producing well is abandoned, date of last production 19  
Was permission obtained from the Conservation Division or its agents before plugging was commenced? yes

Name of Conservation Agent who supervised plugging of this well Archie V. Elving  
Producing formation Depth to top Bottom Total Depth of Well 3781 Feet  
Show depth and thickness of all water, oil and gas formations.

OIL, GAS OR WATER RECORDS

CASING RECORD

FORMATION	CONTENT	FROM	TO	SIZE	PUT IN	PULLED OUT
		0	255'	8 5/8"	255	none
		0	3778	4 1/2"	3778	3039.73

Describe in detail the manner in which the well was plugged, indicating where the mud fluid was placed and the method or methods used in introducing it into the hole. If cement or other plugs were used, state the character of same and depth placed, from feet to feet for each plug set.

Push plug to 3500', set 10' rock bridge and dump 3 sacks of cement.  
Set bridge plug at 250'. Bail hole down and dump 25 sacks of cement.  
Fill hole with mud to 40', set 10' rock bridge and cap with 10 sacks of cement.

RECEIVED  
STATE CORPORATION COMMISSION

JUN 9 1964

6-9-64

CONSERVATION DIVISION  
Wichita, Kansas

(If additional description is necessary, use BACK of this sheet)  
Name of Plugging Contractor Pipe Pullers, Inc.  
Address Box 486, Ellinwood, Kansas

STATE OF Kansas COUNTY OF Barton, ss.  
Dean Wells (employee of owner) or (owner or operator) of the above-described well, being first duly sworn on oath, says: That I have knowledge of the facts, statements, and matters herein contained and the log of the above-described well as filed and that the same are true and correct. So help me God.

(Signature) *Dean Wells*  
Ellinwood, Kansas  
(Address)

SUBSCRIBED AND SWORN TO before me this 8th day of June, 19 64

My commission expires July 7, 1964

*J. Rader*  
Notary Public.

