


Give All Information Completely  
Make Required Affidavit  
Mail or Deliver Report to  
Conservation Division  
State Corporation Commission  
800 Bittig Building  
Wichita, Kansas

WELL PLUGGING RECORD

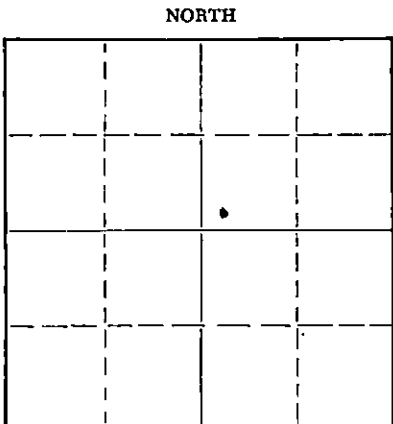

Locate well correctly on above Section Plat

Stafford County, Sec. 27 Twp. 21 Rge. 14 (E)W (W)  
Location as "NE/CNW/SW" or footage from lines SW-SW-NE  
Lease Owner The Lotus Oil Company  
Lease Name Nettie Watzlaff Well No. 2  
Office Address 900 Riss Bldg., Kansas City, 5, Mo.  
Character of Well (completed as Oil, Gas or Dry Hole) Oil Well  
Date well completed April 14 1951  
Application for plugging filed July 30 1956  
Application for plugging approved July 31 1956  
Plugging commenced August 13 1956  
Plugging completed August 17 1956  
Reason for abandonment of well or producing formation No Oil

If a producing well is abandoned, date of last production July 14 1956  
Was permission obtained from the Conservation Division or its agents before plugging was commenced? Yes

Name of Conservation Agent who supervised plugging of this well R.M. Frundege  
Producing formation Kansas City Depth to top 3390 Bottom 3668 Total Depth of Well 3771 Feet  
Show depth and thickness of all water, oil and gas formations.

OIL, GAS OR WATER RECORDS

CASING RECORD

FORMATION	CONTENT	FROM	TO	SIZE	PUT IN	PULLED OUT
		0	254	8-5/8"	254'	None
		0	3652	5-1/2"	3652'	2890'

Describe in detail the manner in which the well was plugged, indicating where the mud fluid was placed and the method or methods used in introducing it into the hole. If cement or other plugs were used, state the character of same and depth placed, from \_\_\_\_\_ feet to \_\_\_\_\_ feet for each plug set.

Plug back with sand to 3470'  
Dumped 5 sacks cement with dump bailer  
Squeezed surface pipe with 20 sacks mud, 2 sacks calcium chloride & 80 sacks cement using Globe Cementing Company  
Cement 14' from top of surface pipe  
Dumped 5 sacks cement to top of surface pipe

RECEIVED  
STATE CORPORATION COMMISSION  
AUG - 1 1956  
CONSERVATION DIVISION  
Wichita, Kansas  
8-31-56

(If additional description is necessary, use BACK of this sheet)  
Name of Plugging Contractor E & L Casing Pulling Co  
Address Great Bend, Kansas

STATE OF Kansas, COUNTY OF Pawnee, ss.  
J.L. Haines (employee of owner) or (owner or operator) of the above-described well, being first duly sworn on oath, says: That I have knowledge of the facts, statements, and matters herein contained and the log of the above-described well as filed and that the same are true and correct. So help me God.

(Signature) J.L. Haines  
Box 30, Larned, Kansas  
(Address)

SUBSCRIBED AND SWORN TO before me this 29 day of August, 1956  
G.W. Hays  
Notary Public.

My commission expires 7-11-57

PLUGGING  
FILE SEC 27T 21 R14W  
BOOK PAGE 85 LINE 15

L-256-L

DRILLER'S LOG

COMPANY: CROWN OIL COMPANY, INC. LOCATION: ~~SW~~ SW NE 27-21-14  
 CONTRACTOR: HILTON DRILLING COMPANY, INC. Stafford County, Kansas  
 FAHN NAME: RATZLAFF NO. 2 ELEVATION: 1931 OR  
 COMMENCED: 3-31-51  
 COMPLETED: 4-14-51  
 CASINO USED: 8-5/8" at 254' with 225 sacks  
 5-1/2" at 3653' with 125 sacks

Sand and Gravel	190
Shale and Sand	275
Sand	320
Red Sand	870
Anhydrite	860
Shale and Shells	1190
Salt and Shale	1250
Shale and Shells	1325
Lime and Shale	1697
Lime	1800
Lime and Shale	1920
Broken Lime	2155
Lime	2215
Shale and Shells	2515
Lime and Shale	2645
Shale and Shells	2780
Shale, Lime and Shells	2850
Lime and Shale	3030
Lime	3628
Lime and Shale	3669
Lime, Shale, Cong., and Chert	3699
Lime and Chert	3717
Lime	3775
Total Depth	3775

PLUGGING  
 FILE SEC 27 T 21 R 14 W  
 BOOK PAGE 85 LINE 15

STATE OF KANSAS )  
 ) SS  
 COUNTY OF BARTON )

I, the undersigned, being duly sworn an oath, state that the above statement and log are true and a correct record and log of the well drilled at the location above described.

RECEIVED  
 COMMISSION

HILTON DRILLING COMPANY, INC.

REGISTRATION DIVISION  
 Kansas

*Henry Peacock, Sr.*  
 \_\_\_\_\_

Subscribed and sworn to before me this 28th day of April, 1951.

*Edwina Elder*  
 \_\_\_\_\_  
 Notary Public

My commission expires September 21, 1951.