


WELL PLUGGING RECORD

Give All Information Completely  
Make Required Affidavit  
Mail or Deliver Report to:  
Conservation Division  
State Corporation Commission  
800 Bittling Building  
Wichita, Kansas

NORTH

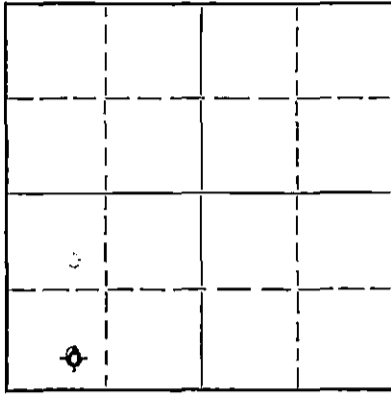

Locate well correctly on above Section Plat

Stafford County, Sec. 27 Twp. 21 Rge. 14W (E) (W)  
Location as "NE/CNW $\frac{1}{4}$ SW $\frac{1}{4}$ " or footage from lines SE $\frac{1}{4}$  SW $\frac{1}{4}$  SW $\frac{1}{4}$   
Lease Owner Anderson-Prichard Oil Corporation  
Lease Name Keenan "B" Well No. 1  
Office Address 1000 Apco Tower, Oklahoma City, Oklahoma  
Character of Well (completed as Oil, Gas or Dry Hole) dry hole  
Date well completed 4-11-1951  
Application for plugging filed 4-11-1951  
Application for plugging approved 4-11-1951  
Plugging commenced 4-11-1951  
Plugging completed 4-11-1951  
Reason for abandonment of well or producing formation

If a producing well is abandoned, date of last production 19  
Was permission obtained from the Conservation Division or its agents before plugging was commenced? yes

Name of Conservation Agent who supervised plugging of this well C. D. Stough  
Producing formation Depth to top Bottom Total Depth of Well 3839 Feet  
Show depth and thickness of all water, oil and gas formations.

OIL, GAS OR WATER RECORDS

CASING RECORD

Formation	Content	From	To	Size	Put In	Pulled Out
			424'	8-5/8"	424'	
			cemented with 300 sacks cement.			

Describe in detail the manner in which the well was plugged, indicating where the mud fluid was placed and the method or methods used in introducing it into the hole. If cement or other plugs were used, state the character of same and depth placed, from feet to feet for each plug set.

Plugged hole with 15 sacks cement on bottom plug at 275'; 10 sacks cement on top plug at 40'.

STATE OF KANSAS  
APR 18 1951  
CONSERVATION DIVISION

4-18-51

(If additional description is necessary, use BACK of this sheet)

Correspondence regarding this well should be addressed to Anderson-Prichard Oil Corp.  
Address

STATE OF KANSAS, COUNTY OF SEDGWICK, ss.  
Richard Hindery partner of Birmingham-Bartlett Drilling Co., contractor of the above-described well, being first duly sworn on oath, says: That I have knowledge of the facts, statements, and matters herein contained and the log of the above-described well as filed and that the same are true and correct. So help me God.

(Signature) Richard Hindery  
(Address)

SUBSCRIBED AND SWORN to before me this 16th day of April, 1951

My commission expires November 29, 1954. *Lincoln J. Ginger* Notary Public.

PLUGGING  
DATE REC'D 4/27/51  
BOOK PAGE 23 LINE 36

KEENAN "B" #1 WELL

LOCATION: SE $\frac{1}{4}$  SW $\frac{1}{4}$  SW $\frac{1}{4}$  Sec. 27-21S-14W  
Stafford County, Kansas

OPERATOR: Anderson-Prichard Oil Corporation

CONTRACTOR: Birmingham-Bartlett Drilling Co.

SURFACE CASING: Ran 427' 8-5/8" 28.55# casing cemented  
at 424' with 300 sacks cement.

OIL STRING: None. D & A.

SPUDDED: 3-29-51

COMPLETED: 4-11-51

L O G

(Figures indicate bottom of formation).

0 to	235	Sand-Clay
	256	Shale
	387	Sand & shells
	424	Red bed
	851	Red bed & shells
	877	Anhydrite
	1190	Redbed, shale & shells
	1795	Shale & shells
	2420	Lime & shale
	2855	Shale & shells
	3454	Shale & lime
	3500	Lime
	3550	Lime & shale
	3670	Lime
	3715	Lime & chert
	3750	Cherty lime & shale
	3780	Shale
	3825	Shale & Arbuckle
	3835	Arbuckle
	3835	Total Depth.

The undersigned Richard Hindery of the Birmingham-Bartlett Drilling Co. hereby certifies that the above is a true and correct log of the formations encountered in drilling the Keenan "B" #1 well as shown on the daily drilling reports.

BIRMINGHAM-BARTLETT DRILLING CO.

BY Richard Hindery

Subscribed and sworn before me  
this 16th day of April, 1951.

Virchow J. Ginger  
Notary Public

My commission expires November 29, 1954.

RECEIVED  
APR 18 1951  
BIRMINGHAM-BARTLETT DRILLING CO.  
Wichita, Kansas

PLUGGING  
PLT SEC 27-T-21 R 14W  
BOOK PAGE 73 of 36