


STATE OF KANSAS  
STATE CORPORATION COMMISSION  
200 Colorado Derby Bldg.  
Wichita, Kansas 67202

Form CP-4  
Rev. 12-15-80

WELL PLUGGING RECORD

Give All Information Completely  
Make Required Affidavit

COUNTY Stafford SEC. 25 TWP. 21S RGE. 13 E/W  
Location as in quarters or footage from lines:  
SE NW SE

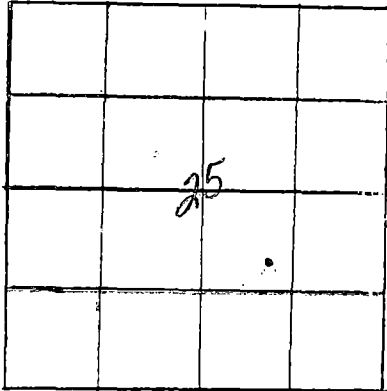

Locate Well  
correctly on above  
Section Platt.

Lease Owner Nadel and Gussman  
Lease Name FISCHER Well No. B-4  
Office Address 3232 First National Tower - Tulsa, OK 74103  
Character of Well (Completed as Oil, Gas or Dry Hole): Oil  
Date Well Completed 11/8/50  
Application for plugging filed 7/2/82  
Plugging commenced 8/18/82  
Plugging completed 8/18/82  
Reason for abandonment of well or producing formation Depleted

Was permission obtained from the Conservation Division or it's  
Agent's before plugging was commenced? yes

Name of Conservation Agent who supervised plugging of this well J. H. Metz  
Producing formation Lansing K.C. Depth to top 3281 bottom 3510 T.D. 3711  
Show depth and thickness of all water, oil and gas formations.

OIL, GAS OR WATER RECORDS Casing Record

Formation	Content	From	To	Size	Put in	Pulled Out
<u>Lansing K.C.</u>	<u>Oil</u>	<u>3464</u>	<u>3472</u>	<u>8-5/8"</u>	<u>320'</u>	<u>none</u>
				<u>5-1/2"</u>	<u>3710'</u>	<u>none</u>

Describe in detail the manner in which the well was plugged, indicating where the mud fluid was placed and the method or methods used in introducing it into the hold. If cement or other plugs were used, state the character of same and depth placed, from \_\_\_\_\_ feet to \_\_\_\_\_ feet for each plug set.  
200 sx 50/50 Poz, 4% Gel, 3% Calcium Chloride with 2 sacks of hulls were pumped down the 5-1/2" and 8-5/8" annulus at the same time. Maximum pressure 300#. Had good squeeze pressure which held at end of job.

(If additional description is necessary, use BACK of this sheet)

Name of Plugging Contractor Allied Cementing Co., Inc. (Russell, Ks.)

STATE OF OKLAHOM COUNTY OF TULSA, ss.

M. R. Taylor, Mgr. of Production (employee of owner) or (owner or operator) of the above-described well, being first duly sworn on oath, says: That I have knowledge of the facts, statements, and matters herein contained and the log of the above-described well as filed and that the same are true and correct. So help me God.

(Signature) MR Taylor  
3232 First National Tower-Tulsa, OK 74103  
(Address)

SUBSCRIBED AND SWORN TO before me this 30th day of August, 19 82

My Commission expires: 5/11/83

Mildred Carter  
Mildred Carter Notary Public.

*Rec. 9-3-82*

WELL LOG

15.185.10653.0000

NADEL AND GUSSMAN

FISCHER B-4

SE NW SE 25-21-13W  
Stafford County  
Kansas.

Commenced 10-27-50

Completed 11-8-50

Casing: 8-5/8" 320' W/200 Sax  
5-1/2" 3710' W/125 Sax

Formations	Depth
Sand and clay	150
Shale, shells, Red bed and Pyrite	323
Shale and Red bed	695
Anhydrite	730
Shale and shells	1490
Broken lime	1605
Lime - shale	1735
Lime	1880
Shale and shells	1920
Broken lime	1960
Lime - shale	2190
Broken lime	2310
Lime - shale	2465
Shale and shells	2785
Shale and lime	2975
Lime	3240
Shale	3300
Lime	3518
Viola chert	3570
Shale	3611
Arbuckle dolomite	3615
Arbuckle	3711

GEOLOGICAL TOPS

Brown Lime	3265
Lansing Limestone	3281
Viola Chert	3513
Simpson Shale	3581
Arbuckle	3611
R.T.D.	3711

STATE CORPORATION COMMISSION  
 JUL 6 1982  
 CONSERVATION DIVISION  
 Wichita, Kansas

STATE OF KANSAS

COUNTY OF SEDGWICK

SS:

L. C. Hay of lawful age being first duly sworn on his oath states that the above formations and depths are true and correct as taken from the daily drilling log of the Fischer B-4 well in the SE NW SE 25-21-13W, Stafford County, Kansas.

*L. C. Hay*

Subscribed and sworn to before me this 10th day of November, 1950.

*Notary Public*  
Notary Public

My commission expires Nov. 3, 1952