


STATE OF KANSAS
STATE CORPORATION COMMISSION

WELL PLUGGING RECORD

Give All Information Completely
Make Required Affidavit
Mail or Deliver Report to:
Conservation Division
State Corporation Commission
800 Bitting Building
Wichita, Kansas

Stafford County. Sec. 25 Twp. 21 Rge. 13 (E) W (W)
Location as "NE/CNW $\frac{1}{4}$ SW $\frac{1}{4}$ " or footage from lines SE NE NW
Lease Owner Nadel and Gussman
Lease Name Fanshier A Well No. 1
Office Address 703 Union National Bank Bldg. Wichita, Kans.
Character of Well (completed as Oil, Gas or Dry Hole) Dry
Date well completed 11-20-1950
Application for plugging filed 11-20-1950
Application for plugging approved 11-20-1950
Plugging commenced 11-20-1950
Plugging completed 11-20-1950
Reason for abandonment of well or producing formation Dry

NORTH

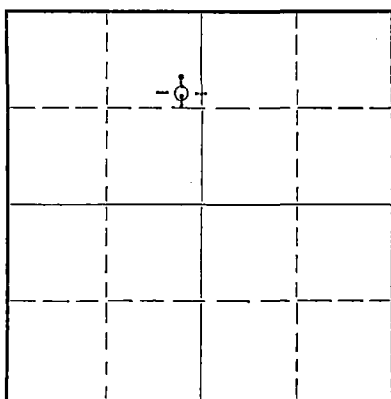

Locate well correctly on above
Section Plat

If a producing well is abandoned, date of last production 19...
Was permission obtained from the Conservation Division or its agents before plugging was com-
menced? Yes

Name of Conservation Agent who supervised plugging of this well C. D. Stough
Producing formation Depth to top Bottom Total Depth of Well 3707 Feet
Show depth and thickness of all water, oil and gas formations.

OIL, GAS OR WATER RECORDS

CASING RECORD

Formation	Content	From	To	Size	Put In	Pulled Out
				8-5/8"	300	None

Describe in detail the manner in which the well was plugged, indicating where the mud fluid was placed and the method or methods used in introducing it into the hole. If cement or other plugs were used, state the character of same and depth placed, from...feet to...feet for each plug set.

Hole filled heavy mud 3707 to 300'
Spotted 20 sacks cement in 8-5/8" @ 300'
Spotted 10 sacks cement in 8-5/8" @ 35'

(If additional description is necessary, use BACK of this sheet)

Correspondence regarding this well should be addressed to Nadel and Gussman
Address P. O. Box 309, Tulsa, Oklahoma

STATE OF KANSAS, COUNTY OF SEDGWICK, ss.

L. C. Hay (employee of owner) or (owner or operator) of the above-described well,
being first duly sworn on oath, says: That I have knowledge of the facts, statements, and matters herein contained and the log of the above-described well as filed and that the same are true and correct. So help me God.

(Signature)

L. C. Hay

703 Union Natl Bank Bldg. Wichita, Kans.
(Address)

SUBSCRIBED AND SWORN to before me this 28th day of November, 1950.

STATE CO.

Wala Babb

Notary Public.

My commission expires Nov. 3, 1952

23-3273-s

4-50-10M

DEC 1 - 1950

CONSERVATION DIVISION
Wichita, Kansas

PLUGGING
FILE SEC. 25 T. 21 R. 13
BOOK PAGE 44 LINE 31

WELL LOG

NAPHEL AND GUSSMAN

FANSHIER A-1

SE NE NW 25-21-13W
Stafford County
Kansas

Comm. 11-11-50
Comp. 11-20-50

Casing: 8-5/8" 306' w/200' sax

Formations	Depth
Red Bed	302
Shale and Red Bed	700
Anhydrite	735
Shale and shells	1470
Broken Lime	1485
Lime-Shale	1675
Broken Lime	2030
Lime-Shale	2535
Shale-Shells	2690
Lime-Shale	3070
Lime	3240
Lime-Shale	3340
Lime	3579
Conglomerate	3642
Lime-Shale	3707 T.D.

Geological Taps

Heebner	3179
Brown Lime	3312
Lansing-K.C.	3329
Conglomerate	3575
Viola Res. Chert	3646
Simpson	3693

STATE OF KANSAS }
COUNTY OF SEDGWICK } SS:

L. C. Hay, of lawful age, being duly sworn states that the above formations and depths are true and correct as taken from the daily drilling log of the Fanshier A-1 well located in the SE NE NW of Section 25-21-13W, Stafford County, Kansas.

L. C. Hay

Subscribed and sworn to before me this 28th day of November, 1950.

Paul B...

Notary Public

My comm. expires Nov. 3 1952

