

STATE OF KANSAS  
STATE CORPORATION COMMISSION


WELL PLUGGING RECORD

Give All Information Completely  
Make Required Affidavit  
Mail or Deliver Report to:  
Conservation Division  
State Corporation Commission  
800 Bittling Building  
Wichita, Kansas

Stafford County. Sec. 25 Twp. 21 Rge. (E) 13 (W)

Location as "NE/CNW 1/4 SW 1/4" or footage from lines SW NW SW  
Lease Owner Nadel and Gussman  
Lease Name Fischer "D" Well No. 5  
Office Address Drawer 309, Tulsa 1, Oklahoma  
Character of Well (completed as Oil, Gas or Dry Hole) Dry Hole  
Date well completed March 22 19 52  
Application for plugging filed March 26 19 52  
Application for plugging approved March 28 19 52  
Plugging commenced March 23 19 52  
Plugging completed March 26 19 52  
Reason for abandonment of well or producing formation

NORTH

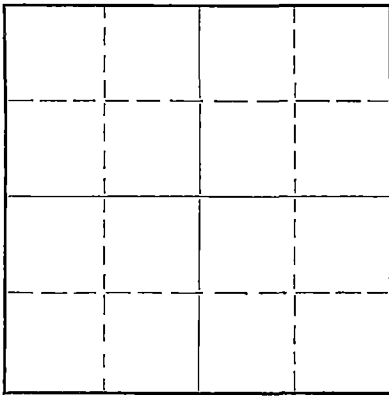

Locate well correctly on above  
Section Plat

If a producing well is abandoned, date of last production 19...  
Was permission obtained from the Conservation Division or its agents before plugging was commenced? Yes

Name of Conservation Agent who supervised plugging of this well M. A. Rives  
Producing formation Depth to top Bottom Total Depth of Well 3717 Feet  
Show depth and thickness of all water, oil and gas formations.

OIL, GAS OR WATER RECORDS

CASING RECORD

Formation	Content	From	To	Size	Put In	Pulled Out
				8 5/8"	343	None
				5 1/2"	3700'	2750'

Describe in detail the manner in which the well was plugged, indicating where the mud fluid was placed and the method or methods used in introducing it into the hole. If cement or other plugs were used, state the character of same and depth placed, from feet to feet for each plug set.

Plugged back with rock to 3380', Dumped 5 sacks cement top of cement 3340', shot pipe at 2800', pulled 5 1/2" casing, bailed hole down and then mudded hole to 300'. Set rock bridge, dumped 15 sacks cement, top of cement 250', mudded hole to 35', set rock bridge, dumped 10 sacks cement for ~~xxxx~~ cap.

APR 23 1952 4-3-52

(If additional description is necessary, use BACK of this sheet)

Correspondence regarding this well should be addressed to Nadel and Gussman  
Address Drawer 309, Tulsa 1, Oklahoma

STATE OF Oklahoma, COUNTY OF Tulsa, ss.  
Herbert Gussman (employee of owner) or (owner or operator) of the above-described well,

being first duly sworn on oath, says: That I have knowledge of the facts, statements, and matters herein contained and the log of the above-described well as filed and that the same are true and correct. So help me God.

(Signature)

*Herbert Gussman*


DRAWER 309, TULSA 1, OKLAHOMA (Address)

SUBSCRIBED AND SWORN TO before me this 31st day of March, 1952

*Jack Brown*

Notary Public.

My commission expires April 1, 1953.

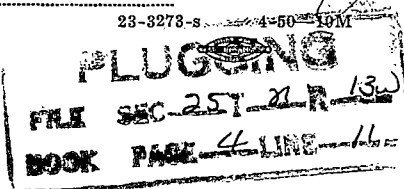

WELL LOG

15.185.11646.0000

HADEL AND GUSMAN

Fischer D-5

SW NW SW 25-21-13W  
Stafford County, Kans.

Coring: 1-4-52  
Comp: 1-17-52

Casing: 8-5/8" 343' w/250 Sax  
5-1/2" 3700' w/150 Sax

Formations	Depths
Sand, gravel and shale	273
Red bed, shale and shells	330
Red bed and shells	345
Red bed	440
Red bed and shale	700
Anhydrite	740
Red bed, shale and shells	980
Shells and shale	1290
Shale, shells and salt	1485
Broken lime	1570
Broken lime and shale	1750
Lime and shale	1900
Florence Flint	1923
Shale and shells	1957
Shale and lime shells	2140
Lime and shale	2270
Shale and lime shells	2385
Shale and lime	2800
Lime	2875
Lime (broken)	2970
Lime and shale	3055
Lime	3133
Lime and shale	3257
Lime	3505
Lime and shale	3552
Lime and chert	3605
Chert	3610
Shale	3673
Lime Arbuckle	3701

ZOOLOGICAL TOPS

Heshner	3169
Br. Lime	3294
Lansing	3311
Viola	3574
Gimpson	3642
Arbuckle	3666(-1789)

STATE OF KANSAS

COUNTY OF SEDGWICK

} SS;

L. C. Hay of lawful age, deposes and states that the above formations and depths are true as taken from the daily drilling log of the Fischer D-5 in the SW NW SW 25-21-13W, Stafford County, Kansas.

*L. C. Hay*

Subscribed and sworn to before me this 22nd day of January, 1952.

*Walter Bush*

Notary Public

My commission expires Nov. 3, 1952

PLUGGING  
 FILE SEC 25-21-13W  
 BOOK PAGE 4 LINE 11