

STATE OF KANSAS
STATE CORPORATION COMMISSION


WELL PLUGGING RECORD

OR
FORMATION PLUGGING RECORD

Strike out upper line
when reporting plug-
ging off formations.

Give All Information Completely
Make Required Affidavit
Mail or Deliver Report to:
Conservation Division
State Corporation Commission
800 Biting Building
Wichita, Kansas

NORTH

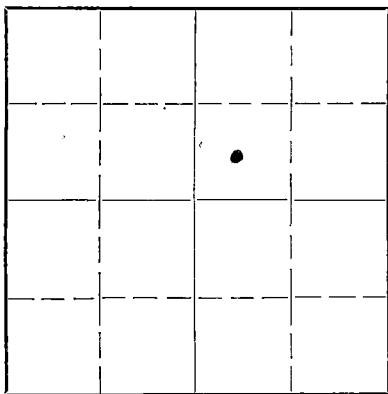

Locate well correctly on above
Section Plat

Stafford County, Sec. 22 Twp. 21S Rge. 13W (E) (W)
Location as "NE 1/4 NW 1/4 SW 1/4" or footage from lines SW/4 - NE/4
Lease Owner The Atlantic Refining Company
Lease Name Hoffman Well No. 1
Office Address P.O. Box 17, Great Bend, Kansas
Character of Well (completed as Oil, Gas or Dry Hole) Dry Hole
Date well completed Sept. 6, 1943 19
Application for plugging filed Sept. 9, 1943 19
Application for plugging approved Verbal Approval Sept. 6, 1943 19
Plugging commenced Sept. 7, 1943 19
Plugging completed Sept. 7, 1943 19
Reason for abandonment of well or producing formation Dry Hole

If a producing well is abandoned, date of last production -- 19
Was permission obtained from the Conservation Division or its agents before plugging was com-
menced? Yes

Name of Conservation Agent who supervised plugging of this well C. T. Alexander
Producing formation None Depth to top Bottom Total Depth of Well 3808' Feet
Show depth and thickness of all water, oil and gas formations.

OIL, GAS OR WATER RECORDS

CASING RECORD

Formation	Content	From	To	Size	Put In	Pulled Out
Shale Sand & Shells		0	256'	10-3/4"OD	256'	None
		Cement circulated from top to bottom.				

Describe in detail the manner in which the well was plugged, indicating where the mud fluid was placed and the method or methods used in introducing it into the hold. If cement or other plugs were used, state the character of same and depth placed, from feet to feet for each plug set.

Filled up from 3808' to 250' with heavy drilling mud
Filled up from 250' to 210' with bridge and cement
Filled up from 210' to 40' with heavy drilling mud
Filled up from 40' to 4' with bridge and cement and cemented over the bottom of the cellar.

(If additional description is necessary, use BACK of this sheet)

Correspondence regarding this well should be addressed to Mr. S. K. Myers
Address P. O. Box 17, Great Bend, Kansas.

STATE OF Kansas, COUNTY OF Barton ss.
Mr. S. K. Myers (employee of owner) or (owner or operator) of the above-described well,
being first duly sworn on oath, says: That I have knowledge of the facts, statements, and matters herein contained and the log of the above-described well as filed and that the same are true and correct. So help me God.

(Signature) Stanton K. Myers
P.O. Box 17, Great Bend, Kansas
(Address)

SUBSCRIBED AND SWORN TO before me this 9th day of September, 19 43
Mary H. Colegrove
Notary Public.

My commission expires March 9, 1946

WELL RECORD

15.185.11396.0000

Lease HOFFMAN
Lease No KS-6523
County Stafford

Block or Twp. 21S-13W

Well No. 1

Location C SW NE Sec. 22-21S-13W

State Kansas

Elevation 1882 Feet

Drilled { Contract x
Company Tools

Contracted Depth 3680
Completed Depth 3808

Feet Date { Started 8-21-43
Completed 9-7-43
Deepened
Cleaned Out

Name of Contractor Simpson & Noble, Inc.

Contract Price Per Foot

Day Work

Well Estimated Cost
Well Actual Cost

Method of Drilling Rotary

BEFORE SHOOTING

AFTER SHOOTING

Initial Production
Settled Production

Flowing
on Pump

Initial Production
Settled Production

Flowing
on Pump

Baume Test

Water With Oil

%

Casing Record

Torpedo Record

SIZE	SET	PULLED
10-3/4" Wheeling		
22.75# L.W.	256'	250 sax

Date	Company	From	To	Feet	Size of Shell	Total Qts.

FORMATION	TOP	BOTTOM
Surface hole	0	262
Sand	262	395
Red rock	395	665
Red bed	665	700
Anhydrite	700	733
Shale & shells	733	1125
Salt	1125	1515
Shale & lime	1515	1721
Lime	1721	1913
Shale & lime	1913	2467
Shale	2467	2700
Shale & lime	2700	2782
Lime	2782	3530
Shale & lime	3530	3617
Shale	3617	3669
Lime	3669	3685
Chert	3685	3720
Conglomerate	3720	3746
Shale	3746	3753
Lime	3753	3756
Shale	3756	3766
Lime	3766	3778
Broken lime & shale	3778	3795
Lime	3795	3808
Total depth		3808

DRY AND ABANDONED



22 21 130
90 21