

STATE OF KANSAS
STATE CORPORATION COMMISSION

Form CP-4

Give All Information Completely
Make Required Affidavit
Mail or Deliver Report to:
Conservation Division
State Corporation Commission
212 No. Market
Wichita, Kansas 67202

WELL PLUGGING RECORD

STAFFORD County. Sec. 22 Twp. 21 Rge. (E) 13 (W)

Location as "NE/CNW%SW%" or footage from lines NE 1/4 SW 1/4 SE 1/4

Lease Owner Cheyenne Exploration Inc

Lease Name Schultz C Well No. 1

Office Address 357 Lulu Wichita KANSAS

Character of Well (completed as Oil, Gas or Dry Hole) Dry hole

Date well completed August 31, 1971 19

Application for plugging filed August 31, 1971 19

Application for plugging approved August 31, 1971 19


Plugging commenced August 31, 1971 19

Plugging completed August 31, 1971 19

Reason for abandonment of well or producing formation Lack of hydrocarbons

If a producing well is abandoned, date of last production _____ 19

Was permission obtained from the Conservation Division or its agents before plugging was commenced? Yes

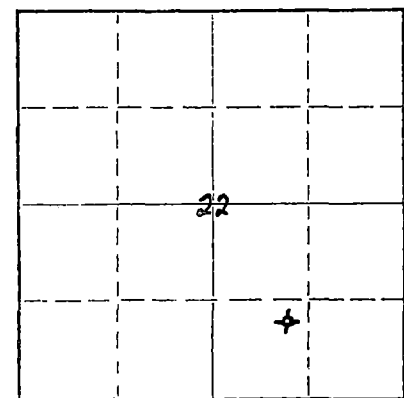

Locate well correctly on above Section Plat

Name of Conservation Agent who supervised plugging of this well G.R. Biberstein

Producing formation None Depth to top _____ Bottom _____ Total Depth of Well 3776 Feet

Show depth and thickness of all water, oil and gas formations.

OIL, GAS OR WATER RECORDS

CASING RECORD

FORMATION	CONTENT	FROM	TO	SIZE	PUT IN	PULLED OUT
<u>LANSING</u>		<u>3342</u>		<u>8 5/8</u>	<u>321'</u>	<u>0</u>
<u>Conglomerate</u>		<u>3686</u>	<u>3776</u>			

Describe in detail the manner in which the well was plugged, indicating where the mud fluid was placed and the method or methods used in introducing it into the hole. If cement or other plugs were used, state the character of same and depth placed, from _____ feet to _____ feet for each plug set.

321 of 8 5/8 surface pipe cemented with 200 sr.

Pumped 20 sacks to 600' with Cement
20 SACKS to 300' with Cement
10 SACKS to 40' with Cement
2 sacks Cement in RAT hole

RECEIVED
STATE CORPORATION COMMISSION
SEP 15 1971
CONSERVATION DIVISION
Wichita, Kansas

Name of Plugging Contractor Cheyenne Exploration Inc (If additional description is necessary, use BACK of this sheet)

Address 357 Lulu

STATE OF _____, COUNTY OF _____, ss.

_____, (employee of owner) or (owner or operator) of the above-described well, being first duly sworn on oath, says: That I have knowledge of the facts, statements, and matters herein contained and the log of the above-described well as filed and that the same are true and correct. So help me God.

(Signature) _____

357 Lulu Wichita Ks
(Address)

Subscribed and sworn to before me this 15th day of September, 1971

Maudie A. Lee
Notary Public.

My commission expires March 31, 1974

