

15009-23007-0020


STATE OF KANSAS
STATE CORPORATION COMMISSION
200 Colorado Derby Bldg.
Wichita, Kansas 67202

Form CP-4
Rev. 12-15-80

WELL PLUGGING RECORD

Give All Information Completely
Make Required Affidavit

COUNTY Barton SEC. 8 TWP. 16 RGE. 13 N/W
Location as in quarters or footage from lines:
W/2 SE NW SE

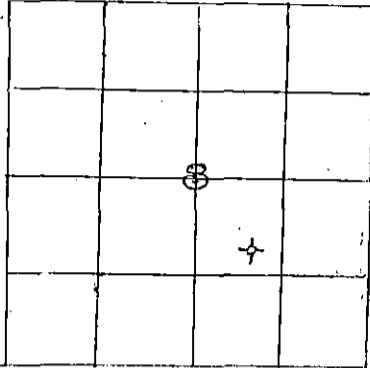

Locate Well
correctly on above
Section Platt.

Lease Owner Texas Energies, Inc.
Lease Name Harms Well No. 1-8
Office Address P.O. Box 947 Pratt, KS 67124
Character of Well (Completed as Oil, Gas or Dry Hole): Dry Hole
Date Well Completed 5-20-83
Application for plugging filed 5-31-83
Plugging commenced 5-20-83
Plugging completed 5-20-83
Reason for abandonment of well or producing formation _____

Dry Hole
Was permission obtained from the Conservation Division or it's
Agent's before plugging was commenced? Yes

Name of Conservation Agent who supervised plugging of this well Ed Shoemaker

Producing formation --- Depth to top --- bottom --- T.D. 3460

Show depth and thickness of all water, oil and gas formations.

OIL, GAS OR WATER RECORDS

Casing Record

Formation	Content	From	To	Size	Put in	Pulled Out
				8 5/8	252	None

Describe in detail the manner in which the well was plugged, indicating where the mud
fluid was placed and the method or methods used in introducing it into the hold. If cement
or other plugs were used, state the character of same and depth placed, from _____ feet
to _____ feet for each plug set.

Plugged well with 140 sxs 50/50 poz 4% Gel 3% CC
as follows:

- 20 sxs at 3450'
- 20 sxs at 920'
- 80 sxs at 480'
- 10 sxs and solid bridge at 40'
- rathole with 10 sxs

(If additional description is necessary, use BACK of this sheet)

Name of Plugging Contractor Wheatstate Drilling

STATE OF Kansas COUNTY OF Pratt, ss.
E. H. Bittner (employee of owner) or ~~Kansas XXXXXXXXXX~~ of the
above-described well, being first duly sworn on oath, says: That I have knowledge of the
facts, statements, and matters herein contained and the log of the above-described well as
filed and that the same are true and correct. So help me God.

(Signature) EHBittner
P.O. Box 947 Pratt, KS 67124
(Address)

SUBSCRIBED AND SWORN TO before me this 31st day of May, 19 83

Juanita Dick
Notary Public.

My Commission expires: 5-12-85

