


STATE OF KANSAS  
STATE CORPORATION COMMISSION

WELL PLUGGING RECORD

Provide All Information Completely  
No Required Affidavit  
File or Deliver Report to  
Conservation Division  
State Corporation Comm.  
245 North Water  
Wichita, KS 67202

Location as "NE/CNW/SW" or footage from lines 10 County. Sec. 10 Twp. 21 Rge. 8 E/W  
Lease Owner SE SE 516  
Lease Name Brooklyn Exploration, Inc. Well No. 1  
Office Address 1905 S. 2nd St. #606  
Character of Well (Completed as Oil, Gas or Dry Hole) Gas

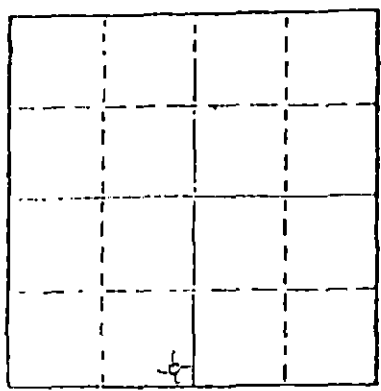

Locate well correctly on above Section Plot

Date Well completed 1977  
Application for plugging filed 8-16 1977  
Application for plugging approved 9-16 1977  
Plugging commenced 8-21 1977  
Plugging completed 9-5 1977  
Reason for abandonment of well or producing formation 71

If a producing well is abandoned, date of last production 1977

Was permission obtained from the Conservation Division or its agents before plugging was commenced? Yes

Name of Conservation Agent who supervised plugging of this well John E. Hayes  
Producing formation Brooklyn Depth to top 2375 Bottom 2375 Total Depth of Well 2375  
Show depth and thickness of all water, oil and gas formations.

OIL, GAS OR WATER RECORDS

CASING RECORD

FORMATION	CONTENT	FROM	TO	SIZE	PUT IN	PULLED OUT
						2364

Describe in detail the manner in which the well was plugged, indicating where the mud fluid was placed and the method or methods used in introducing it into the hold. If cement or other plugs were used, state the character of same and depth placed, from \_\_\_\_\_ feet to \_\_\_\_\_ feet for each plug set.

first plug to 2375 and 2nd plug to 2350 feet 2' each of cement plugs each 15' of mud hole out fill with sandy soil.

RECEIVED  
STATE CORPORATION COMMISSION  
AUG 18 1980  
CONSERVATION DIVISION  
Wichita, Kansas

(If additional description is necessary, use BACK of this form)  
Name of Plugging Contractor John E. Hayes

STATE OF Kansas COUNTY OF Renov, ss.  
John E. Hayes (employee of owner) or (owner or operator)  
of the above-described well, being first duly sworn on oath, says: That I have knowledge of the facts, statements, and matters herein contained and the log of the above-described well filed and that the same are true and correct. So help me God.

(Signature) John E. Hayes

(Address) \_\_\_\_\_

SUBSCRIBED AND SWORN TO before me this 20th day of September, 1977

My commission expires Feb 11th 1980

Everlita E. Hayes  
Notary Public.  
EVERLITA E. HAYES  
NOTARY PUBLIC  
RENO COUNTY, KANSAS

DRILLERS' WELL LOG

DATE COMMENCED: May 8, 1979  
DATE COMPLETED: May 16, 1979

Energy Exploration, Inc.  
"BOOTH # 1"  
SE SE SW  
Sec 10, T21S, R8W  
Rice, County, Ks.

0 - 180' Sand, Clay  
180 - 408' Red Bed  
408 - 1418' Sahle, Shells, Salt & Lime  
1418 - 2747' Shale & Lime  
2747 - 2751' Shale  
2751 - 2769' Shale & Lime  
2769 - 2781' Lime  
2781 - 2893' Shale  
2893 - 2922' Lime & Shale  
2922 - 3244' Lime  
3244 - 3375' Lime, Shale, Chert  
3375' RTD

ELEVATION: 1645 K.B.

<u>FORMATION DATA</u>	
Heebner	2747
Toronto	2769
Douglas	2781
Brown Lime	2893
Kansas City	2922
Base- K.C.	3244
Marmaton	3253
Conglomerate	3295
Kinderhook Sh.	3332
RTD	3375

SURFACE PIPE: Set  
230' of 8 5/8" pipe  
20#, w/175 sacks  
60/40 pozmix, 2 % gel.  
3 % cc. /

PRODUCTION PIPE: Set  
new 4 1/2" pipe, 9 1/2 #,  
at 3374' w/50 sacks  
common w/10# gelsonite  
and 50 sacks common,  
18 % salt.

A F F I D A V I T

State of Kansas  
County of Barton ) ss.

Leonard Williamson, of lawful age does swear and state that the facts and statements herein contained are true and correct to the best of his knowledge.

RECEIVED  
STATE CORPORATE COMMISSION

AUG 20 1979

*Leonard Williamson*

Subscribed and sworn to before me this 17 day of May, 1979

*Margaret M. Waage*  
Notary Public

My Comm. Expires: April 11, 1982