


Give All Information Completely  
Make Required Affidavit  
Mail or Deliver Report to:  
Conservation Division  
State Corporation Commission  
211 No. Broadway  
Wichita, Kansas

WELL PLUGGING RECORD

Rice County, Sec. 10 Twp. 21 Rge. 8 (E) W (W)

Location as "NE/CNW/SW" or footage from lines SW NE NW  
Lease Owner Sterling Drilling Company  
Lease Name Wilkey Well No. 1  
Office Address Sterling, Kansas  
Character of Well (completed as Oil, Gas or Dry Hole) Gas  
Date well completed February 10, 1957  
Application for plugging filed November 26, 1962  
Application for plugging approved November 27, 1962  
Plugging commenced 12-3-62 19  
Plugging completed 12-6-62 19  
Reason for abandonment of well or producing formation Depleted.

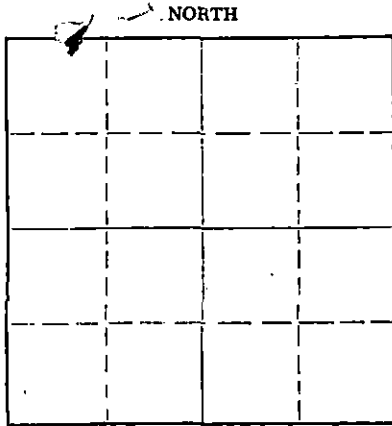

Locate well correctly on above Section Plat

If a producing well is abandoned, date of last production November 1, 19 62  
Was permission obtained from the Conservation Division or its agents before plugging was commenced? yes

Name of Conservation Agent who supervised plugging of this well Gilbert Toman  
Producing formation Mississippi Depth to top 3278' Bottom 3292' Total Depth of Well 3330 Feet  
Show depth and thickness of all water, oil and gas formations.

OIL, GAS OR WATER RECORDS

CASING RECORD

FORMATION	CONTENT	FROM	TO	SIZE	PUT IN	PULLED OUT
				8-5/8"	200'	None
				5-1/2"	3330'	2731'

Describe in detail the manner in which the well was plugged, indicating where the mud fluid was placed and the method or methods used in introducing it into the hole. If cement or other plugs were used, state the character of same and depth placed, from \_\_\_\_\_ feet to \_\_\_\_\_ feet for each plug set.

Checked hole to 3300', sanded to 3270' and dumped 5 sacks of cement @ 3270' with dump bailer. Pulled 5 1/2" casing. Bailed hole from 20' to 200', set rock bridge to 190' and ran 20 sacks of cement @ 190'. Mudded to 40', set rock bridge to 30' and ran 10 sacks of cement to base of cellar.

STATE CORPORATION COMMISSION

PLUGGING COMPLETE.

DEC 14 1962

CONSERVATION DIVISION  
Wichita, Kansas

12-14-1962

Name of Plugging Contractor KNIGHT CASING PULLING COMPANY  
Address CHASE, KANSAS

STATE OF KANSAS, COUNTY OF RICE, ss.  
Noel J. Knight (employee of owner) or (~~owner or operator~~) of the above-described well, being first duly sworn on oath, says: That I have knowledge of the facts, statements, and matters herein contained and the log of the above-described well as filed and that the same are true and correct. So help me God.

(Signature) Noel J. Knight  
Chase, Kansas  
(Address)

SUBSCRIBED AND SWORN TO before me this 11th day of December, 1962

My commission expires May 20, 1964

Milton J. Tolin  
Notary Public.

WELL LOG ----- WILKEY #1

Location: SW NE NW, 10-21S-8W,  
Rice County, Kansas

OWNER: Sterling Drilling Company, et al  
ROTARY DRILLING CONTRACTOR: Sterling Drilling Company  
CABLE TOOLS CONTRACTOR: Sterling Drilling Company

COMMENCED: 1-19-57 (w. r.)  
              : 2-4-57 (w.c.t.)

COMPLETED: 1-28-57 (w. r.)  
              : 2-9-57 (w.c.t.)

TOTAL DEPTH: 3330'

LOG

0 - 180	Clay & Sand
180 - 350	Red Bed
350 - 1080	Shale & Shells
1080 - 1360	Lime
1360 - 1725	Shale & Lime
1725 - 1825	Lime
1825 - 2150	Shale
2150 - 2515	Shale & Lime
2515 - 2585	Lime
2585 - 2685	Lime & Shale
2685 - 2780	Lime
2780 - 2920	Shale
2920 - 3120	Lime
3120 - 3190	Lime & Shale
3190 - 3220	Lime
3220 - 3290	Shale & Conglomerate
3290 - 3330	Lime T. D.

CASING RECORD

Ran 200' of 8-5/8" casing  
set with 135 sacks cement  
and 2 sacks calcium chloride.

Set 5-1/2" casing at 3330'  
with 60 sacks cement.

CABLE TOOLS M.I.C.T. Rigged up and swabbed hole down. Perforated 3278-3292'  
with 4 jets per foot. Acidized with 500 gal. M.C.A. and left well overnight.  
Acid fraced with 2500 gal. Jel. acid. Swabbed gas well in.

**RECEIVED**  
STATE CORPORATION COMMISSION

NOV 27 1962

CONSERVATION DIVISION  
Wichita, Kansas