

STATE OF KANSAS  
STATE CORPORATION COMMISSION

WELL PLUGGING RECORD

Give All Information Completely  
Make Required Affidavit  
Mail or Deliver Report to  
Conservation Division  
State Corporation Comm.  
245 North Water  
Wichita, KS 67202

Kiowa County, Sec. 2 Twp. 28S Rge. 19 ~~E/W~~  
Location as "NE/CNW $\frac{1}{2}$ SW $\frac{1}{2}$ " or footage from lines  
SE NE

Lease Owner TGT Petroleum Company  
Lease Name PYLE Well No. 2

Office Address 209 East William, Wichita, Kansas 67202  
Character of Well (Completed as Oil, Gas or Dry Hole)


Dry Hole

Date Well completed July 9 1976  
Application for plugging filed (verbally) July 9 1976  
Application for plugging approved (verbally) July 9 1976  
Plugging commenced July 9 1976  
Plugging completed July 9 1976

Reason for abandonment of well or producing formation  
No commercial quantity of oil or gas encountered  
If a producing well is abandoned, date of last production 19

Was permission obtained from the Conservation Division or its agents before plugging was commenced? Yes

Name of Conservation Agent who supervised plugging of this well Dwane Rankin  
Producing formation Depth to top Bottom Total Depth of Well 4880'  
Show depth and thickness of all water, oil and gas formations.

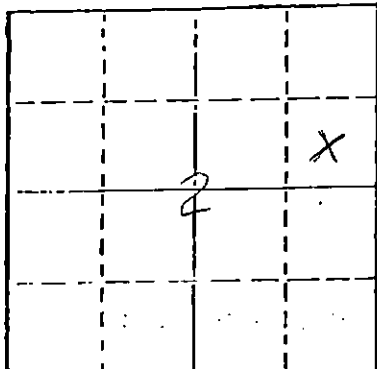

Locate well correctly on above Section Plat

OIL, GAS OR WATER RECORDS FILED

CASING RECORD

FORMATION	CONTENT	FROM	TO	SIZE	PUT IN	PULLED OUT
STATE				8-5/8"	400'	None
JUL 13 1976 7-13-76						

CONSERVATION DIVISION  
Wichita, Kansas

Describe in detail the manner in which the well was plugged, indicating where the mud fluid was placed and the method or methods used in introducing it into the hold. If cement or other plugs were used, state the character of same and depth placed, from feet to feet for each plug set.

1st Plug set @ 420' with 50 sx.  
2nd Plug set @ 40' with 10 sx. and 1/2 sx. cotton hulls  
Rathole with 5 sx.

Plug was down @ 3:30 a.m. on July 9, 1976.  
State Pluggger: Dwane Rankin

(If additional description is necessary, use BACK of this sheet)

Name of Plugging Contractor Abercrombie Drilling, Inc.  
801 Union Center, Wichita, Kansas 67202


STATE OF KANSAS COUNTY OF SEDGWICK ss.

Jerry A. Langrehr, Exec. V. P. (employee of owner) or (owner or operator) of the above-described well, being first duly sworn on oath, says: That I have knowledge of the facts, statements, and matters herein contained and the log of the above-described well as filed and that the same are true and correct. So help me God.

(Signature) Jerry A. Langrehr  
801 Union Center, Wichita, Kansas 67202 (Address)

Subscribed and Sworn to before me this 12th day of July 1976

Sandra Richman  
Sandra Richman Notary Public.

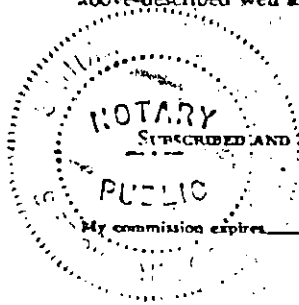

July 21, 1979

CONTRACTOR'S WELL LOG

OPERATOR: TGT Petroleum Company  
 CONTRACTOR: Abercrombie Drilling, Inc.  
 WELL NAME: PYLE #2  
 LOCATION: SE NE Section 2-28S-19W  
 Kiowa County, Kansas  
 GEOLOGIST: Al Stude  
 SPUD DATE: June 22, 1976  
 COMPLETION DATE: July 9, 1976

0	382	Sand
382	633	Blue Shale & Sand
633	1000	Red Bed & Clay
1000	1551	Shale & Sand
1551	2001	Red Bed Shales
2001	2155	Shale & Shells
2155	2350	Shale & Lime
2350	2960	Lime & Shale
2960	3085	Lime-Cherty
3085	3415	Lime & Shale
3415	3988	Lime
3988	4096	Lime & Shale
4096	4187	Lime & Chert
4187	4265	Shale
4265	4405	Lime
4405	4457	Lime & Shale
4457	4842	Lime
4842	4857	Chert
4857	4867	Lime
4867	4880	Shale
	4880	Rotary Total Depth

**COPY**

RECEIVED  
 STATE OF KANSAS COMMISSION

JUL 13 1976

CONSERVATION DIVISION  
 Wichita, Kansas

Spud @ 2:00 a.m. on June 22, 1976. Drilling @ 412', preparing to rat hole ahead. Ratholed ahead to 1000'. Backed up and ran surface casing. Ran 13 jts, of 8-5/8", 28# used casing, set @ 400' and cemented with 200 sx. of 50/50 Posmix, 4% gel, 3% ca. cl., and 175 sx. Common, 3% ca. cl. Cement circulated. Plug was down @ 1:00 a.m. on 6-23-76.

T.D. 4880'. Plugged with 50 sx. @ 420', 10 sx. and 1/2 sx. cotton hulls @ 40', 5 sx. rathole. Plug was down @ 3:30 a.m. on July 9, 1976. State Plugger: Dwane Rankin.

STATE OF KANSAS )  
 ) SS  
 COUNTY OF SEDGWICK )

Jerry A. Langrehr, Executive Vice President of Abercrombie Drilling, Inc., does hereby state that the above and foregoing is a true and correct copy of the log of the PYLE #2, SE NE Section 2-28S-19W, Kiowa County, Kansas.

ABERCROMBIE DRILLING, INC.

By: Jerry A. Langrehr  
 Jerry A. Langrehr, Exec. V P.

Subscribed and sworn to before me, a Notary Public, in and for the aforesaid county and state as of this 12th day of July, 1976.

Sandra Richman  
 Sandra Richman - Notary Public

My Commission Expires: July 21, 1979.

