


STATE OF KANSAS
STATE CORPORATION COMMISSION

Form CP-4

WELL PLUGGING RECORD

Give All Information Completely
Make Required Affidavit
Mail or Deliver Report to:
Conservation Division
State Corporation Commission
212 No. Market
Wichita, Kansas 67202

NORTH

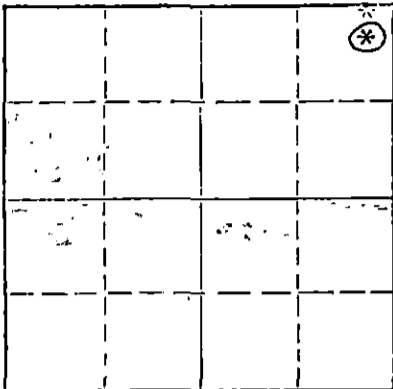

Locate well correctly on above
Section Plat

Rice County. Sec. 10 Twp. 21S Rge. 6W (E) (W)
Location as "NE/CNW/SW" or footage from lines NE NE NE
Lease Owner Clarence Herrman
Lease Name McKee Well No. 1
Office Address 1600 Odaniel Hutchinson, Kansas 67501
Character of Well (completed as Oil, Gas or Dry Hole) Oil
Date well completed 4/29 19 69
Application for plugging filed 3/18 4-28 19 71
Application for plugging approved 19
Plugging commenced 19
Plugging completed 19
Reason for abandonment of well or producing formation No Oil

If a producing well is abandoned, date of last production No Production 19
Was permission obtained from the Conservation Division or its agents before plugging was commenced?

Name of Conservation Agent who supervised plugging of this well
Producing formation Mississippi Lime Depth to top 3060 Bottom 3435 Total Depth of Well 3435 Feet
Show depth and thickness of all water, oil and gas formations.

OIL, GAS OR WATER RECORDS

CASING RECORD

FORMATION	CONTENT	FROM	TO	SIZE	PUT IN	PULLED OUT
Surface Clay		0	40			
sand		40	150			
sand & Shale		150	195			
Shale		195	210	8 5/8	210 Ft	Cement
Lime & Shale		3065	3440	5 1/2	3440	75 Sack of cement

Describe in detail the manner in which the well was plugged, indicating where the mud fluid was placed and the method or methods used in introducing it into the hole. If cement or other plugs were used, state the character of same and depth placed, from feet to feet for each plug set.

Fill hole with sand 3396 to 3360 set 30 ft. cement plug
from 3360 to 3330. Filled hole with mud Pulled pipe from
2908 set plug at 205 filled with rock to 190 ran 3 1/2 yards
of ready mix concrete from 190ft. to bottom of celler

RECEIVED
STATE CORPORATION COMMISSION
JUN 22 1971
CONSERVATION DIVISION
Wichita, Kansas

(If additional description is necessary, use BACK of this sheet)
Name of Plugging Contractor Glenn & Smith Pipe Pulling Co.
Address Ellinwood Kansas

STATE OF KANSAS, COUNTY OF SEDGWICK, ss.
Clarence Herrman (employee of owner) or (owner or operator) of the above-described well, being first duly sworn on oath, says: That I have knowledge of the facts, statements and matters herein contained and the log of the above-described well as filed and that the same are true and correct. So help me God.

(Signature) Clarence Herrman
1600 Odaniel Hutchinson Kansas
(Address)

SUBSCRIBED AND SWORN TO before me this 18 day of June, 1971

My commission expires May 26, 1974

Connie Lewis
Notary Public.