15.159.03997.0000

STATE OF KANSAS
STATE CORPORATION COMMISSION

Give All Information Completely
Make Required Affidavit
Mail or Deliver Report to:
Conservation Division
State Corporation Commission
800 Bitting Building
Wichita, Kansas

WELL PLUGGING RECORD

NORTH

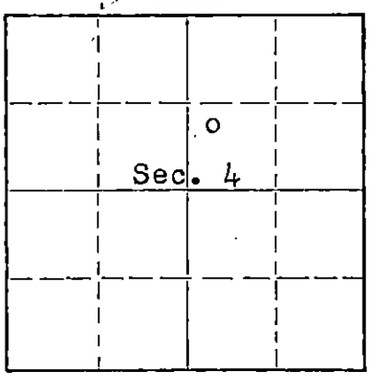

Locate well correctly on above Section Plat

RICE County. Sec. 4 Twp. 21 Rge. 7 (E) W (W)

Location as "NE/CNW¼SW¼" or footage from lines NW SW NE

Lease Owner PETROLEUM, INC.

Lease Name ENGELLAND Well No. 2

Office Address 311 East Third, Wichita, Kansas

Character of Well (completed as Oil, Gas or Dry Hole) oil

Date well completed December 30 19 48

Application for plugging filed June 6 19 56

Application for plugging approved June 8 19 56

Plugging commenced July 2 19 56

Plugging completed July 7 19 56

Reason for abandonment of well or producing formation
Depletion of producible zones

If a producing well is abandoned, date of last production December 24 19 55

Was permission obtained from the Conservation Division or its agents before plugging was commenced? yes

Name of Conservation Agent who supervised plugging of this well Ruel Durkee, McPherson, Kansas

Producing formation Conglomerate Depth to top 3349' Bottom --- Total Depth of Well 3356 Feet

Show depth and thickness of all water, oil and gas formations.

OIL, GAS OR WATER RECORDS — CASING RECORD

FORMATION	CONTENT	FROM	TO	SIZE	PUT IN	PULLED OUT
Conglomerate	Little Oil	3350'	3356'	8-5/8"OD	114'	None
	and water			5-1/2"OD	3350'	3000'

Describe in detail the manner in which the well was plugged, indicating where the mud fluid was placed and the method or methods used in introducing it into the hole. If cement or other plugs were used, state the character of same and depth placed, from _____ feet to _____ feet for each plug set.

Filled hole with crushed rock from 3356' to 3346', and placed 6 sacks cement on top of rock. Mudded up to 175' and made solid rock bridge on top of mud. Placed 25 sacks cement on top of rock bridge and mudded up to 20'. Made solid rock bridge and filled hole to base of well cellar with 5 sacks cement.

RECEIVED
STATE CORPORATION COMMISSION
JUL 14 1956
CONSERVATION DIVISION
Wichita, Kansas
7-14-1956

(If additional description is necessary, use BACK of this sheet)

Name of Plugging Contractor Morgan Well Plugging Service

Address 102 West 18th Street, Hutchinson, Kansas

STATE OF KANSAS, COUNTY OF BARTON, ss.

Don Searle (employee of owner) or ~~(owner or operator)~~ of the above-described well, being first duly sworn on oath, says: That I have knowledge of the facts, statements, and matters herein contained and the log of the above-described well as filed and that the same are true and correct. So help me God.

(Signature) Don Searle

Assistant Production Supt.

Petroleum, Inc., Rural Route 2, Great Bend, Kansas
(Address)

SUBSCRIBED AND SWORN TO before me this 11th day of July, 19 56

Jay E. Anderson
Notary Public.

My commission expires November 21, 1957

PLUGGING
FILE SEC 4 T 21 R 7W
BOOK PAGE 69 LINE 14

5-44M

WELL LOG

15.159.03997.0000

COMPANY Petroleum, Inc.

SEC. 4 T. 21S R. 7W.

FARM ENGELLAND NO. 2

LOC. NW SW NE

TOTAL DEPTH 3356'

COUNTY Rice

COMM. 11-12-48 COMP. 11-22-48

CONTRACTOR Pabco Drilling, Inc.

CASING 8 5/8" 114' cemented with 75 sax bulk cement; cement circulated. Production casing: 5½" set at 3350'.

ELEVATION 1618 DF

PRODUCTION Conglomerate

FIGURES INDICATE BOTTOM OF FORMATIONS

sand, shale and shells	114
shale and shells	625
Anhydrite	650
shale	870
salt and shale	1000
shale and shells	1060
lime and shale	1305
lime and shale	1510
lime	1540
lime and shale	2455
lime	2635
lime and shale	2850
lime	3170
lime and shale	3275
lime	3350
Total Depth	3356

Tops: Conglomerate 3349'

RECEIVED
STATE CORPORATION COMMISSION
JUL 16 1956
CONSERVATION DIVISION
Wichita, Kansas

PLUGGING
FILE SEC 4 T 21 R 7W
BOOK PAGE 69 LINE 14

State of Kansas }
County of Rice } ss:

I, Cullen Thomas of Petroleum, Inc.

upon oath state that the above and foregoing is a true and correct copy of the log of the ENGELLAND #2 well

Cullen Thomas

Subscribed and sworn to before me this 12th day of July 19 56

My Commission Expires: Sept 2, 1959

Frances Sloan
NOTARY PUBLIC

FRANCES SLOAN, Notary Public
My Commission expires Sept. 2, 1959