

**Give All Information Completely
Make Required Affidavit
Mail or Deliver Report to:
Conservation Division
State Corporation Commission
800 Bittling Building
Wichita, Kansas**

WELL PLUGGING RECORD

NORTH

**Locate well correctly on above
Section Plat**

RICE County, Sec. 4 Twp. 21 Rge. ~~2E~~ 7 (W)
Location as "NE/CNW $\frac{1}{4}$ SW $\frac{1}{4}$ " or footage from lines SE SW NE
Lease Owner PETROLEUM, INC., et. al.
Lease Name ENGELLAND Well No. 3
Office Address Derby Building, Wichita, Kansas
Character of Well (completed as Oil, Gas or Dry Hole) DRY HOLE
Date well completed 12/19/48 19
Application for plugging filed 2/03/49 19
Application for plugging approved 2/04/49 19
Plugging commenced 2/03/49 19
Plugging completed 2/09/49 19
Reason for abandonment of well or producing formation DRY

If a producing well is abandoned, date of last production 19.....
Was permission obtained from the Conservation Division or its agents before plugging was com-
menced? Yes

Name of Conservation Agent who supervised plugging of this well. Ruel Durkee
Producing formation..... Depth to top..... Bottom..... Total Depth of Well..... 3392 Feet
Show depth and thickness of all water, oil and gas formations.

OIL, GAS OR WATER RECORDS

CASING RECORD

[illegible]

Describe in detail the manner in which the well was plugged, indicating where the mud fluid was placed and the method or methods used in introducing it into the hole. If cement or other plugs were used, state the character of same and depth placed, from.....feet tofeet for each plug set.

Dumped 6 sacks of cement at 3350'. Shot pipe off at 3228'. Pulled pipe and mudded hole to 118'. Dumped 15 sacks of cement at 118'. Finished mudding hole and put 5 sacks of cement at top of surface.

~~RECEIVED~~

~~Conservation: 34~~

FEB 16 1949

STATE CONFERENCE
COMMISSION

14159

(If additional description is necessary, use BACK of this sheet)

Correspondence regarding this well should be addressed to.....PETROLEUM, INC.
Address.....Derby Building.....2-16-1949
.....Wichita, Kansas

STATE OF Kansas, COUNTY OF Sedgwick, ss.
Charles M. Searle (employee of owner) or (owner or operator) of the above-described well,
 being first duly sworn on oath, says: That I have knowledge of the facts, statements, and matters herein contained and the log of the above-described well as filed and that the same are true and correct. So help me God.

(Signature) Charles W. Slack

Derby Building, Wichita, Kansas
(Address)

SUBSCRIBED AND SWORN to before me this 14th day of February, 19 49

My commission expires October 27, 1952

22-5133-s 9-48-10M

PLUGGING

WELL LOG

Petroleum, Inc.

Engelland #3

Sec. 4; T 21S; R 7W

SE SW NE

County: Rice

Total Depth: 3400'

Comm: 11-26-48 Comp: 12-6-48

Contractor: Pabco Drilling, Inc.

Rotary O-3363'

Elevation 1617 D. F.

Production: Dry

Cable Tool 3363' to 3400'

Casing: 8 5/8" 119' cemented with 100 sax
bulk cement; cement circulated

Figures indicate bottoms of Formations:

soil and clay	15
sand, shale and shells	600
Anhydrite	630
shale	1075
lime and shale	1210
lime	1540
lime, shale and shells	2350
lime	2800
lime and shale	2940
lime	3225
lime and shale	3363
lime and shale	3400
Total Depth	3400

Tops: Conglomerate	3356
Mississippian Lime	3392

We hereby certify this to be a correct and accurate log of the above described well as shown on the daily drilling reports.

PETROLEUM, INC.

BY

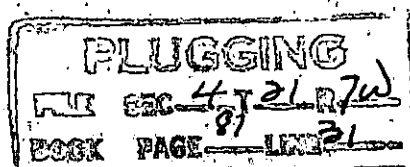
Charles M. Searle

Charles M. Searle, Asst. Secretary

Subscribed and sworn to before me this 5th day of January, 1949.

My commission expires:

March 7, 1952

Josephine A. Searle
Notary Public

WELL LOG

Petroleum, Inc.
Engelland #3

Sec. 4; T 2LS; R 7W
SE SW NE
County: Rice

Total Depth: 3400'
Comm: 11-26-48 Comp: 12-6-48
Contractor: Pabco Drilling, Inc.
Rotary 0-3363'
Cable Tool 3363' to 3400'

Elevation 1617 D. F.
Production: Dry

Casing: 8 5/8" 119' cemented with 100 sax
bulk cement; cement circulated

Figures indicate bottoms of Formations:

soil and clay	15
sand, shale and shells	600
Anhydrite	630
shale	1075
lime and shale	1210
lime	1540
lime, shale and shells	2350
lime	2800
lime and shale	2940
lime	3225
lime and shale	3363
lime and shale	3400
Total Depth	3400

Tops: Conglomerate 3356
Mississippian Lime 3392

We hereby certify this to be a correct and accurate log of the above described well as shown on the daily drilling reports.

PETROLEUM, INC.

BY

Charles M. Searle
Charles M. Searle, Asst. Secretary

Subscribed and sworn to before me this 5th day of January, 1949.

My commission expires:

October 27, 1952

Marjorie Brackshaw
Notary Public

RECEIVED
OCT 14 1948
FEB 14 1949
STATE CORPORATION
COMMISSION
KANSAS