


Give All Information Completely  
Make Required Affidavit  
Mail or Deliver Report to:  
Conservation Division  
State Corporation Commission  
800 Bittner Building  
Wichita, Kansas

WELL PLUGGING RECORD

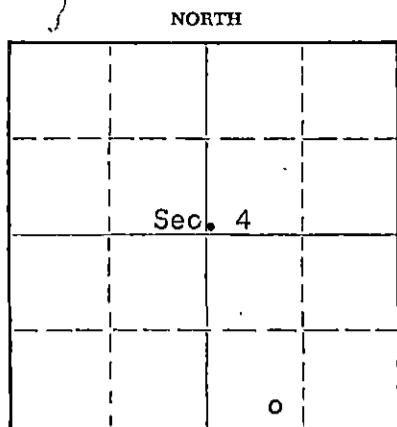

Locate well correctly on above Section Plat

Rice County, Sec. 4 Twp. 21 Rge. 7 (##) W (W)  
Location as "NE/CNWxSWx" or footage from lines SE SW SE  
Lease Owner Petroleum, Inc.  
Lease Name THEEDE Well No. 4  
Office Address 311 East Third, Wichita, Kansas  
Character of Well (completed as Oil, Gas or Dry Hole) Oil  
Date well completed November 11 19 50  
Application for plugging filed June 6 19 56  
Application for plugging approved June 8 19 56  
Plugging commenced July 9 19 56  
Plugging completed July 11 19 56  
Reason for abandonment of well or producing formation Depletion of producible zones.  
If a producing well is abandoned, date of last production February 28 19 56  
Was permission obtained from the Conservation Division or its agents before plugging was commenced? yes

Name of Conservation Agent who supervised plugging of this well Ruel Durkee  
Producing formation Conglomerate Depth to top 3321' Bottom ----- Total Depth of Well 3357 Feet  
Show depth and thickness of all water, oil and gas formations.

OIL, GAS OR WATER RECORDS

CASING RECORD

FORMATION	CONTENT	FROM	TO	SIZE	PUT IN	PULLED OUT
Conglomerate (open hole)	Little oil & water	<del>3357</del> 3344'	3357'	8-5/8"OD 5-1/2"OD	123' 3344'	None 3,000'

Describe in detail the manner in which the well was plugged, indicating where the mud fluid was placed and the method or methods used in introducing it into the hole. If cement or other plugs were used, state the character of same and depth placed, from \_\_\_\_\_ feet to \_\_\_\_\_ feet for each plug set.

Filled hole with crushed rock from 3357' to 3335', and placed 6 sacks cement on top of rock. Mudded up to 175' and made solid rock bridge on top of mud. Placed 25 sacks of cement on top of rock bridge and mudded up to 20'. Made solid rock bridge and filled hole to base of well cellar with 5 sacks cement.

(If additional description is necessary, use BACK of this sheet)

Name of Plugging Contractor Morgan Well Plugging Service  
Address 102 West 18th Street, Hutchinson, Kansas

STATE OF KANSAS, COUNTY OF BARTON, ss.  
Don Searle (employee of owner) or (owner or operator) of the above-described well, being first duly sworn on oath, says: That I have knowledge of the facts, statements, and matters herein contained and the log of the above-described well as filed and that the same are true and correct. So help me God.

(Signature) Don Searle  
Don Searle, Asst. Prod. Supt,  
Rural Route #2, Great Bend, Kansas  
(Address)

SUBSCRIBED AND SWORN TO before me this 14 day of July, 1956

My commission expires May 3, 1957

Mabel Pugh Notary Public.

PLUGGING  
FILE SEC 4 T 21 R 7W  
BOOK PAGE 69 LINE 12


7-17-1956

THEBDE WELL #4

Casing Record:	COMPANY:	Petroleum, Inc.	Description:
8-5/8" - 120'	CONTRACTOR:	Aylward Drilling Co.	SE/4 SW/4 SE/4 of Section 4-218-7W, Rice Co., Kansas
5 1/2" - 3344'	COMMENCED:	October 28, 1950	Elevation:
	COMPLETED:	November 11, 1950	Production:

<u>Formation</u>	<u>From</u>	<u>To</u>	<u>Remarks</u>
Clay	0	8	
Gravel	8	32	
Clay	32	43	
Gravel	43	61	
Red Rock	61	110	
Anhydrite	110	123	8-5/8" casing set at 120'
Red Bed and shale	123	255	
Shale	255	650	
Shale and shells	650	985	
Lime gyp	985	1160	
Shale and lime	1160	1910	
Shale	1910	2060	
Shale and shells	2060	2265	
Shale and lime	2265	2375	
Lime	2375	2905	
Lime and shale	2905	2985	
Lime	2985	3205	
Shale and lime	3205	3333	
Lime	3333	3343	
Conglomerate	3343	3356.58'	5 1/2" casing set at 3344' and cemented w/50 sax.
		T. D. 3356.58'	

I certify that this is a true and correct copy of the above log to the best of my knowledge.

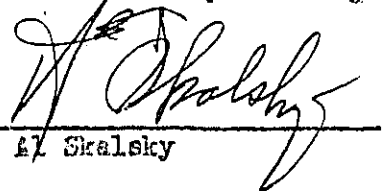  
A. L. Skalsky

Subscribed and sworn to before me this 16th day of November, 1950.

  
Notary Public

My commission expires  
July 16, 1952.

