

STATE OF KANSAS  
STATE CORPORATION COMMISSION


WELL PLUGGING RECORD

OR  
FORMATION PLUGGING RECORD

Strike out upper line when reporting plugging of formations.

Give All Information Completely  
Make Required Affidavit  
Mail or Deliver Report to:  
Conservation Division  
State Corporation Commission  
800 Bittling Building  
Wichita, Kansas

RICE County. Sec 4 Twp 21 Rge. ~~7~~ 7 (W)  
Location as "NE 1/4 NW 1/4 SW 1/4" or footage from lines NE NE NE  
Lease Owner PETROLEUM, INC., et. al.  
Lease Name COLLE Well No. 1  
Office Address Derby Building, Wichita, Kansas  
Character of Well (completed as Oil, Gas or Dry Hole) DRY HOLE  
Date well completed 12/29/48 19  
Application for plugging filed 2/3/49 19  
Application for plugging approved 2/4/49 19  
Plugging commenced 1/27/49 19  
Plugging completed 2/4/49 19  
Reason for abandonment of well or producing formation DRY  
If a producing well is abandoned, date of last production 19  
Was permission obtained from the Conservation Division or its agents before plugging was commenced? Yes

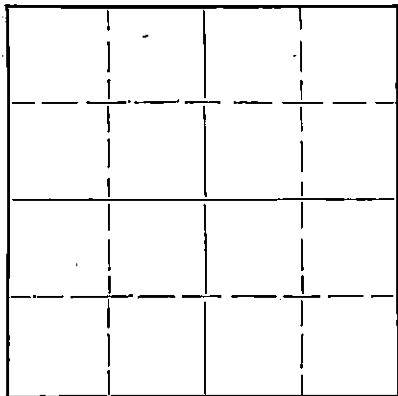

Locate well correctly on above Section Flat

Name of Conservation Agent who supervised plugging of this well Ruel Durkee  
Producing formation Depth to top Bottom Total Depth of Well 3371 Feet  
Show depth and thickness of all water, oil and gas formations.

OIL, GAS OR WATER RECORDS

CASING RECORD

Formation	Content	From	To	Size	Put In	Pulled Out
		0	113	8 5/8	12/9/48	
		0	3348	5 1/2	12/20/48	2/4/49

Describe in detail the manner in which the well was plugged, indicating where the mud fluid was placed and the method or methods used in introducing it into the hole. If cement or other plugs were used, state the character of same and depth placed, from feet to feet for each plug set.

Dumped 6 sacks of cement at bottom of hole. Shot pipe off at 3206'. Pulled pipe and mudded hole to 110'. Dumped 15 sacks of cement at 110'. Finished mudding hole and put 5 sacks of cement at top of surface.

RECEIVED  
CONSERVATION DIV.  
FEB 16 1949  
STATE CORPORATION COMMISSION  
KANSAS

2-16-1949

(If additional description is necessary, use BACK of this sheet)

Correspondence regarding this well should be addressed to PETROLEUM, INC.  
Address Derby Building, Wichita, Kansas

STATE OF Kansas, COUNTY OF Sedgwick, ss.  
Charles M. Searle (employee of owner) or (owner or operator) of the above-described well,

being first duly sworn on oath, says: That I have knowledge of the facts, statements, and matters herein contained and the log of the above-described well as filed and that the same are true and correct. So help me God.

(Signature) Charles M. Searle  
Derby Building, Wichita, Kansas (Address)

SUBSCRIBED AND SWORN to before me this 14th day of February, 1949

Marjorie Bradshaw  
Notary Public.

My commission expires October 27, 1952

PLUGGING  
FILE SEC 4 T 21 R 7W  
BOOK PAGE 81 LINE 32

WELL LOG

Petroleum, Inc.  
Colle #1

Sec. 4; T 21; R 7W  
NE NE NE  
County: Rice

Total Depth: 3372.66'  
Comm: 12-9-48 Comp: 12-20-48  
Contractor: Petroleum, Inc.  
Issued: 1-5-49 Rotary O-3372'

Elevation 1619 D. F.  
Production: Dry

Casing: 8 5/8", 102', cemented with  
100 sacks of regular cement  
and 1 sack of C. C. with  
Halliburton process

Figures indicate bottoms of Formations:

0 to 112	surface soil and sand and lime	
435	red bed and shale	
920	shale and shell	
1308	shale and shells	
1410	lime	
1580	shale and lime	
1765	lime	
1960	shale and lime	
2325	lime and shale	
2390	shale	Tops: Conglomerate 3334
2475	lime and shale	
2570	lime	
2637	lime and shale	
2819	lime and shale	
2875	lime and shale	
2935	lime	
3075	lime and shale	
3181	lime	
3217	lime and shale	
3333	lime	
3345	lime and shale	
3351	Total Depth	

We hereby certify this to be a correct and accurate log of the above described well as shown on the daily drilling reports.

PETROLEUM, INC.

BY Charles M. Searle  
Charles M. Searle

Subscribed and sworn to before me this 5th day of January, 1949.

FEB 19 1949  

Marjorie Bradshaw  
Notary Public

My commission expires:

October 27, 1962

**PLUGGING**  
FILE SEC 4 T 21 R 7 W  
BOOK PAGE 8 LINE 27