


WELL PLUGGING RECORD

Give All Information Completely  
Make Required Affidavit  
Mail or Deliver Report to:  
Conservation Division  
State Corporation Commission  
211 No. Broadway  
Wichita, Kansas

T 21S NORTH R 7W

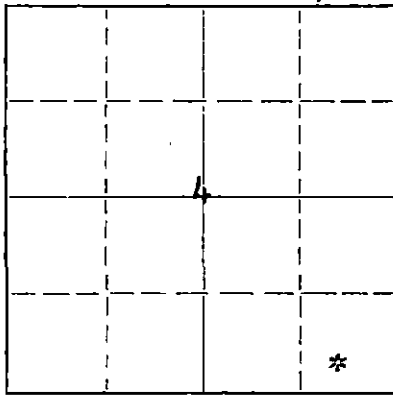

Locate well correctly on above Section Plat

Rice County, Sec. 4 Twp. 21S Rge. 7W (E) (W)

Location as "NE/CNW/SW" or footage from lines. SW SE SE  
Lease Owner Clay V. Phillips  
Lease Name George Theede Well No. 1  
Office Address 430 West 23rd. - Hutchinson, Kansas  
Character of Well (completed as Oil, Gas or Dry Hole) ~~XXXXXXXX~~ Oil well  
Date well completed May 9 19 55  
Application for plugging filed January 6 19 56  
Application for plugging approved January 10 19 56  
Plugging commenced January 9 19 56  
Plugging completed January 11 19 56  
Reason for abandonment of well or producing formation Depleted.

If a producing well is abandoned, date of last production December 19 55  
Was permission obtained from the Conservation Division or its agents before plugging was commenced? Yes

Name of Conservation Agent who supervised plugging of this well Ruel Durkee  
Producing formation \_\_\_\_\_ Depth to top \_\_\_\_\_ Bottom \_\_\_\_\_ Total Depth of Well 3351 Feet  
Show depth and thickness of all water, oil and gas formations.

OIL, GAS OR WATER RECORDS

CASING RECORD

| FORMATION | CONTENT | FROM | TO | SIZE   | PUT IN | PULLED OUT |
|-----------|---------|------|----|--------|--------|------------|
|           |         |      |    | 8-5/8" | 161'   | None       |
|           |         |      |    | 5-1/2" | 3338'  | 2902'      |
|           |         |      |    |        |        |            |
|           |         |      |    |        |        |            |
Describe in detail the manner in which the well was plugged, indicating where the mud fluid was placed and the method or methods used in introducing it into the hole. If cement or other plugs were used, state the character of same and depth placed, from \_\_\_\_\_ feet to \_\_\_\_\_ feet for each plug set.

Filled the hole with sand from 3351' to 3330' and ran 6 sacks of cement. Mudded the hole to 150', set a 10' rock bridge and ran 15 sacks of cement. Mudded the hole to 30', set a 10' rock bridge and ran 50 sacks of cement on top. Plugging completed.

RECEIVED  
JAN 13 1956  
CONSERVATION DIVISION

(If additional description is necessary, use BACK of this sheet)  
Name of Plugging Contractor West Supply Co., Inc.  
Address Chase, Kansas 1-14-1956

STATE OF Kansas, COUNTY OF Rice, ss.  
C. V. Phillips (owner or operator) of the above-described well, being first duly sworn on oath, says: That I have knowledge of the facts, statements, and matters herein contained and the log of the above-described well as filed and that the same are true and correct. So help me God.

(Signature) C. V. Phillips  
Hutchinson, Kansas  
(Address)

SUBSCRIBED AND SWORN TO before me this 13th day of January, 19 56  
Edward E. Bruns  
Notary Public.

My commission expires May 20, 1957

PLUGGING  
FILE SEC 4 T 21S R 7W  
BOOK PAGE 30 LINE 1

WELL LOG BUREAU--KANSAS GEOLOGICAL SOCIETY  
508 East Murdock, Wichita, Kansas


Company. STEARNS PETROLEUM, INC.  
Farm. Theede No. 1

SEC. 4 T. 21 R. 7W  
SW SE SE

Total Depth. 3351  
Comm. 4-29-55 Comp. 5-9-55  
Shot or Treated.  
Contractor. Stearns Petroleum, Inc.  
Issued. 6-25-55

County Rice

KANSAS

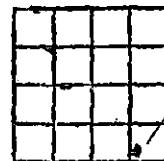

Elevation. 1611 DF

Production. Dry

CASING:

8 5/8 161' w/ 150 sx cmt.  
5 1/2 @ 3338' w/ 100 sx cmt.

Figures indicate Bottom of Formations

|                    |      |
|--------------------|------|
| shale & shells     | 400  |
| red bed & shale    | 600  |
| shale & shells     | 1120 |
| lime & shale       | 2440 |
| lime               | 2781 |
| lime & shale       | 3055 |
| sandy lime & shale | 3078 |
| lime               | 3351 |
| Total Depth        |      |

SCOUT TOPS:

|              |      |
|--------------|------|
| Lansing      | 2899 |
| Conglomerate | 3318 |

STATE OF KANSAS  
JAN 7 - 1956  
CONSERVATION DIVISION

PLUGGING  
WELL SEC. 4 T. 21 R. 7W  
BOOK PAGE 30 LINE 1

STATE OF KANSAS  
JAN 10 1956  
CONSERVATION DIVISION  
Wichita, Kansas