


WELL PLUGGING RECORD

Give All Information Completely
Make Required Affidavit
Mail or Deliver Report to:
Conservation Division
State Corporation Commission
800 Bittling Building
Wichita, Kansas

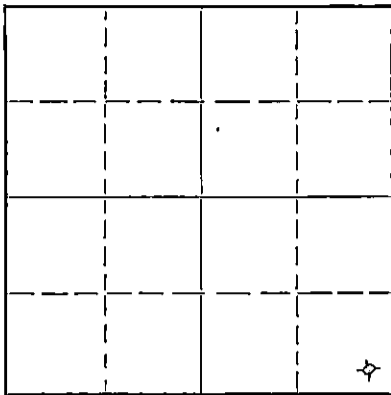

Locate well correctly on above Section Plat

Rice County. Sec. 8 Twp. 21 Rge. (E) 10 (W)
Location as "NE/CNW 1/4 SW 1/4" or footage from lines SE SE SE
Lease Owner Lee Phillips Oil Company
Lease Name Routledge Well No. 1
Office Address 1107 Union National Bank Bldg., Wichita, Kansas
Character of Well (completed as Oil, Gas or Dry Hole) Dry Hole
Date well completed March 26, 1953 19
Application for plugging filed March 26, 1953 19
Application for plugging approved March 26, 1953 19
Plugging commenced March 26, 1953 19
Plugging completed March 26, 1953 19
Reason for abandonment of well or producing formation Dry Hole

If a producing well is abandoned, date of last production 19
Was permission obtained from the Conservation Division or its agents before plugging was commenced? Yes

Name of Conservation Agent who supervised plugging of this well Ruel Durkee
Producing formation Depth to top Bottom Total Depth of Well 3473 Feet
Show depth and thickness of all water, oil and gas formations.

OIL, GAS OR WATER RECORDS

CASING RECORD

Formation	Content	From	To	Size	Put In	Pulled Out
	Surface Pipe	0	224'	8-5/8"	224'	0

Describe in detail the manner in which the well was plugged, indicating where the mud fluid was placed and the method or methods used in introducing it into the hole. If cement or other plugs were used, state the character of same and depth placed, from feet to feet for each plug set.

Filled hole with heavy mud to 215'. Bridged hole at 215'. Ran 20 sacks cement on top of bridge. Set bridge at 35'. Ran 5 sacks cement, plug 35' to base of cellar.

3-30-1953

RECEIVED
STATE CORPORATION COMMISSION

(If additional description is necessary, use BACK of this sheet)

Name of Plugging Contractor Isarn Drilling Company
Address P. O. Box 45, Ellinwood, Kansas

STATE OF KANSAS, COUNTY OF BARTON, ss.
M. M. Shropshire (employee of owner) or (agent or operator) of the above-described well, being first duly sworn on oath, says: That I have knowledge of the facts, statements, and matters herein contained and the log of the above-described well as filed and that the same are true and correct. So help me God.

(Signature) M. M. Shropshire
Lyons, Kansas (Address)

SUBSCRIBED AND SWORN to before me this 26th day of March, 1953
George A. Meyer
Notary Public.

My commission expires Feb. 10, 1955.

PLUGGING
FILE SEC 8 T 21 R 10W
BOOK PAGE 87 LINE 44

WELL LOG

LEE PHILLIPS OIL COMPANY, Owner - Routledge #1
SE/4 SE/4 SE/4 Section 8, Township 21, Range 10W,
Rice County, Kansas

Elevation: 1731 DF

Figures indicate bottom of formation
0 to 99 sand

Pips Record:

8-5/8" set at 224'

Tops: RBM

Heebner 2919
Brown Lime 3054
Kansas City 3078
Conglomerate 3369
Arbuckle 3458

1405 red bed
433 Anhydrite
880 shale & shells
1225 salt
1430 shale & shells
1600 lime & shale
1695 lime
2030 lime & shale
2545 shale & shells
2855 lime & shale
3010 lime
3095 lime & shale
3400 lime
3458 Conglomerate
3473 Arbuckle
3473 Total Rotary Depth D&A

Rotary Commenced 3-16-53
Completed 3-26-53

STATE OF KANSAS)
COUNTY OF BARTON) SS

I, M. M. Shropshire, Drilling Superintendent of the above-described well, being first duly sworn on oath, declare: That I have knowledge of the facts, statements and matters herein contained pertaining to the log of the above-described well, as filed, and that the same are true and correct.

PLUGGING
FILE SEC 8 T 21 R 10W
BOOK PAGE 87 LINE 44

M. M. Shropshire

Subscribed and Sworn to before me this 26th day of March, 1953.

My commission expires Feb. 10, 1954

RECEIVED
STATE CORPORATION COMMISSION
MAR 30 1953
George A Meyer
CONSERVATION
W-1