

WELL PLUGGING RECORD

Give All Information Completely
Make Required Affidavit
Mail or Deliver Report to:
Conservation Division
State Corporation Commission
212 North Market, Insurance Bldg.
Wichita, Kansas

Rice County, Sec. 19 Twp. 21S Rge. 8W ~~XXXXXX~~

Location as "NE/CNW/SW" or footage from lines 330' E/North Line 660' F/West Line (NE)

Lease Owner Sinclair Oil & Gas Company

Lease Name Dill Well No. 1

Office Address P. O. Box 521, Tulsa, Oklahoma

Character of Well (completed as Oil, Gas or Dry Hole) Dry Hole

Date well completed 3-27-62 19

Application for plugging filed 3-28-62 19

Application for plugging approved 3-28-62 19


Plugging commenced 3-27-62 19

Plugging completed 3-27-62 19

Reason for abandonment of well or producing formation Dry Hole

If a producing well is abandoned, date of last production _____ 19

Was permission obtained from the Conservation Division or its agents before plugging was commenced? Yes

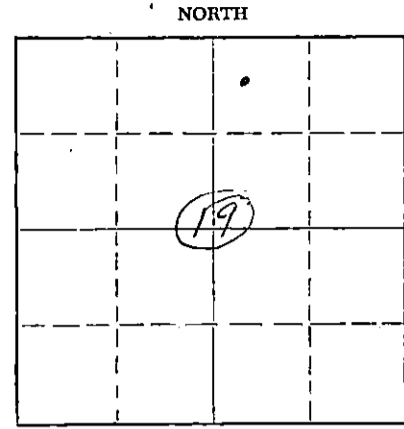

Locate well correctly on above Section Plat

Name of Conservation Agent who supervised plugging of this well Fred W. Hampel

Producing formation None Depth to top _____ Bottom _____ Total Depth of Well _____ Feet

Show depth and thickness of all water, oil and gas formations.

OIL, GAS OR WATER RECORDS

CASING RECORD

FORMATION	CONTENT	FROM	TO	SIZE	PUT IN	PULLED OUT
<u>None encountered</u>				<u>10-3/4"</u>	<u>305'</u>	<u>None</u>

Describe in detail the manner in which the well was plugged, indicating where the mud fluid was placed and the method or methods used in introducing it into the hole. If cement or other plugs were used, state the character of same and depth placed, from _____ feet to _____ feet for each plug set.

Mudded hole from TD 3537' to 300' - Spotted 25 sacks cement from 300' to 250',
Mudded from 250' to 30' and from 30' to surface with 15 sacks cement - Hole
plugged as per Mr. F. W. Hampel, State oil well inspector's instructions.
Completed plugging and abandoning at 4:15 AM 3-27-62

STATE CORPORATION COMMISSION

APR 17 1962

CONSERVATION DIVISION
WICHITA, KANSAS

4-19-1962

(If additional description is necessary, use BACK of this sheet)

Name of Plugging Contractor Barbours Drilling Company

Address Tulsa, Oklahoma

STATE OF Kansas, COUNTY OF Rice, ss.

Donald N. Mooney (employee of owner) or (owner or operator) of the above-described well, being first duly sworn on oath, says: That I have knowledge of the facts, statements, and matters herein contained and the log of the above-described well as filed and that the same are true and correct. So help me God.

(Signature) Donald N. Mooney

Box 466, Chase, Kansas
(Address)

SUBSCRIBED AND SWORN TO before me this 6th day of April, 19 62

My commission expires 8-13-62

L. B. Reynolds Notary Public.

15.159 .00628.0000

DILL NO. 1

NE/4 of Section 19-21S-8W
Rice County, Kansas
Sinclair Oil & Gas Company

10-3/4" casing cemented at 307'

Drilling commenced 3-14-62
Drilling completed 3-27-62

FROM	TO	FORMATION	REMARKS
0'	60'	Clay & sand	
60	85	Sand	
85	307	Red bed	10-3/4" O. D. casing cemented with 350 sacks at 307'
307	795	Shale & shells	
795	1050	Shale & salt	
1050	1150	Anhydrite & salt	
1150	1390	Lime & shale	
1390	1525	Lime	
1525	1761	Lime & shale	
1761	2335	Shale & lime	
2335	2480	Lime & shale	
2480	2780	Lime	
2780	2875	Lime & shale	
2875	3230	Lime	
3230	3275	Lime & shale	
3275	3316	Lime	
3316	3355	Shale	
3355	3408	Shale & lime	
3408	3505	Lime	
3505	3537	Lime & chert	Well Plugged

STATE CORPORATION COMMISSION
APR 17 1962
CONSERVATION DIVISION
Wichita, Kansas

T. D. 3537'

This is a true copy of the driller's log as shown on the drilling tickets.

BARBOUR DRILLING COMPANY

BY: *E. W. Pribil*

Subscribed and sworn to before me on this 13th day of April, 1962.

Merry Jane Burt
Notary Public

My commission expires July 27, 1965